

MISSISSIPPI DEPARTMENT OF NATURAL RESOURCES

Bureau of Land and Water Resources

Southport Mall

P.O. Box 10631

Jackson, Mississippi 39209

WATER WELL DRILLERS LOG

Wayne  
G 2037  
5-22-85

L

May 22 1985 *Port. Drilling & Log* Wayne  
date well completed firm name county well located

LANDOWNER: *J F Jordan*  
*RT 1 Box 250*  
*Waynesboro Ms.*  
(mailing address)

| description of formations encountered | from      | to         |
|---------------------------------------|-----------|------------|
| <i>sand &amp; clay</i>                | <i>0</i>  | <i>14</i>  |
| <i>clm.</i>                           | <i>14</i> | <i>18</i>  |
| <i>rock stratum</i>                   | <i>18</i> | <i>50</i>  |
| <i>clm.</i>                           | <i>50</i> | <i>53</i>  |
| <i>fine sand &amp; clay</i>           | <i>53</i> | <i>60</i>  |
| <i>hard clay sand</i>                 | <i>60</i> | <i>71</i>  |
| <i>clm.</i>                           | <i>71</i> | <i>87</i>  |
| <i>Wicksburg rock</i>                 | <i>87</i> | <i>120</i> |

WELL LOCATION:

sec. *15* T. *9* N. R. *8* E.  
S. W.  
*8* miles *NW* of *Waynesboro*  
(distance) (direction) (nearest town)

WELL PURPOSE: *drill*  
(home, irrigation, municipal, industrial)

*63' 1 1/2" galv. pipe*

WELL COMPLETION DATA:

- (1) diameter (inches) *2*
- (2) total depth (feet) *120*
- (3) static water level (feet) *27* (below) above top of ground.
- (4) casing *galv.* (material) *89'* (depth)  
*2"* (size) If telescope see back.
- (5) screen *none used* (length) (depth to top)  
(size) (material)
- (6) pump *1* (HP) *12* (yield gpm)  
*elec.* (type power)
- (7) electric log *no* (yes or no)  
(organization running log)
- (8) how well bottom plugged *open*

RECEIVED

JUL 23 1985


DRILLERS REMARKS:

*20' 4" P.V.C. surface cas.*

Department of Natural Resources  
Bureau of Land & Water Resources

If well telescopes please sketch and show depths.

GROUND LEVEL

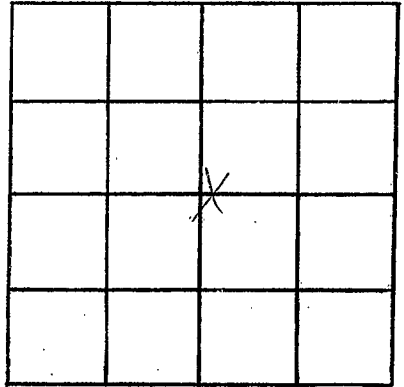

SECTION 15

Please indicate well location X.

ADDITIONAL INFORMATION

If more than one screen,  
show locations of each on sketch.