

WAYNE  
G 2038

MISSISSIPPI  
BOARD OF WATER COMMISSIONERS  
416 North State Street  
Jackson, Mississippi 39201

WATER WELL DRILLERS LOG


1986 CARRS Well SERV WAYNE  
date well completed firm name county well located

LANDOWNER: <u>FLOSSY STREET</u>	description of formations encountered	from	to
RT1 <u>Shubertans</u> <u>Box 264</u> 39360 (mailing address)			
WELL LOCATION: sec. <u>22</u> T. <u>9</u> N. R. <u>8</u> E <u>4 1/2</u> miles <u>NORTH</u> of <u>Whistler</u> (distance) (direction) (nearest town)	Top Soil	0	1
WELL PURPOSE: <u>Home</u> (home, irrigation, municipal, industrial)	Red SANDY CLAY	1	65
WELL COMPLETION DATA:	White CLAY	15	25
(1) diameter (inches) <u>2"</u>	White CREAMY CLAY	25	58
(2) total depth (feet) <u>230</u>	Blue CLAY	58	68
(3) static water level (feet) <u>98</u> <input checked="" type="checkbox"/> below top of ground.	Fine BROWN SAND	68	72
(4) casing <u>PVC</u> <u>210</u> (material) (depth)	Brown + White CLAY	72	76
(size) if telescope see back.	Blue MARI	76	105
(5) screen <u>None</u> (length) (depth to top)	GRAY CLAY	105	114
(size) (material)	BROWN ROCK	114	117
(6) pump <u>2</u> <u>6</u> (HP) (yield gpm)	GRAY CLAY	117	125
<u>Elect</u> (type power)	HARD Lime Rock	125	127
(7) electric log <u>no</u> (yes or no)	GRAY CLAY	127	132
(organization running log)	LIME ROCK	132	133
(8) how well bottom plugged <u>OPEN</u>	Blue MARI	133	135
DRILLERS REMARKS:	GRAY CLAY	135	146
	HARD Lime Rock	146	147
	Med soft Lime Rock	147	150
	HARD Lime Rock	150	153
	LIME ROCK	153	159
	GRAY CLAY	159	164
	Med GRAY SAND	164	185
	GRAY shale	185	195
	HARD Lime Rock	195	197
	SOFT Lime Rock	197	198
	HARD Lime Rock	198	199
	BROKEN Lime Rock	199	230
	T.D.		

RESTRICTED  
JUL 22 1986

If well telescopes please sketch and show depths.

GROUND LEVEL

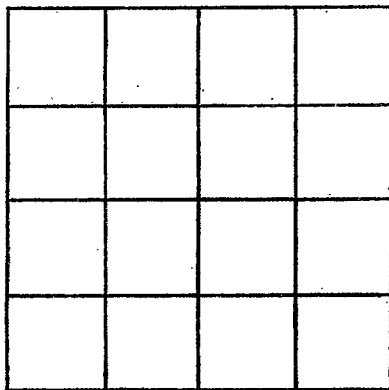

SECTION \_\_\_\_\_

Please indicate well location X.

ADDITIONAL INFORMATION

If more than one screen, show locations of each on sketch.