

WAYNE
G
2057

MISSISSIPPI
BOARD OF WATER COMMISSIONERS
416 North State Street
Jackson, Mississippi 39201

WATER WELL DRILLERS LOG

date well completed 1986 CARRS Well Serv firm name WAYNE county well located

LANDOWNER: Edward Pugh
RT 1 Box 49 Shilbetta
MS 39360
(mailing address)

WELL LOCATION:
sect. 15 T. 9 N. R. 8 E. S. 3 W.
4 1/2 miles NNE of Whistler
(distance) (direction) (nearest town)

WELL PURPOSE: Home
(home, irrigation, municipal, industrial)

- WELL COMPLETION DATA:
- (1) diameter (inches) 2
 - (2) total depth (feet) 142
 - (3) static water level (feet) 20 below top of ground.
 - (4) casing PVC, 124'
(material) (depth)
(size) If telescope see back.
 - (5) screen None
(length) (depth to top)
(size) (material)
 - (6) pump 1, 12
(HP) (yield gpm)
Elect
(type power)
 - (7) electric log NO
(yes or no)
(organization running log)
 - (8) how well bottom plugged open


description of formations encountered	depth	
	from	to
Top Soil	0	5
GRAY CLAY	5	15
PINK + GRAY CLAY	15	25
Blue MARL	25	32
GRAY ROCK	32	33
Blue MARL	33	34
GRAY ROCK	34	37
Med SAND	37	38
Blue MARL	38	78
GRAY CLAY	78	88
HARD Lime Rock	88	89 1/2
SOFT Lime Rock	89 1/2	90 1/2
HARD Lime Rock	90 1/2	91
SOFT Lime	91	92
HARD Lime Rock	92	93
Med SOFT Lime Rock	93	96
HARD Lime Rock	96	97
Med SOFT Lime Rock	97	98 1/2
HARD Lime Rock	98 1/2	99 1/2
SOFT Lime Rock	99 1/2	102
HARD Lime Rock	102	104
SOFT Lime Rock	104	106
Med FIRM L. Rock	106	111 1/2
SOFT Lime	111 1/2	112
HARD Lime Rock	112	113
Med SOFT L. Rock	113	123
Sticky Lime	123	140
Med SOFT to FIRM		
Lime Roc	140	142

DRILLERS REMARKS: SHALE TRAP @ 96'

Department of Natural Resources
Division of Land & Water
22 1986

If well telescopes please sketch and show depths.

GROUND LEVEL

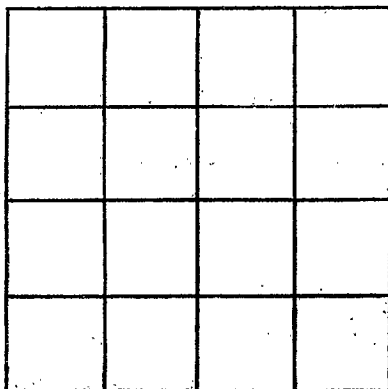

SECTION _____

Please indicate well location X.

ADDITIONAL INFORMATION

If more than one screen, show locations of each on sketch.