

MISSISSIPPI DEPARTMENT OF NATURAL RESOURCES

Bureau of Land and Water Resources

Southport Mall

P.O. Box 10631

Jackson, Mississippi 39209

WATER WELL DRILLERS LOG

WAYNE  
G  
2040

7/22 1986 CARB'S WELL SER WAYNE  
date well completed firm name county well located


LANDOWNER: BO EDISON  
RT. 1  
WAYNESBORO, MS.  
(mailing address)

WELL LOCATION:  
sec. 20 T. 9 N. R. 8 E. S. 5  
miles W of WHISLER  
(distance) (direction) (nearest town)

WELL PURPOSE: HOME  
(home, irrigation, municipal, industrial)

WELL COMPLETION DATA:  
(1) diameter (inches) 2"  
(2) total depth (feet) 181'  
(3) static water level (feet) 90' below top of ground.  
(4) casing P.V.C. 176'  
(material) (depth)  
2" (size) if telescope see back.  
(5) screen 5' 176'  
(length) (depth to top)  
2" STAINLESS S.  
(size) (material)  
(6) pump 1 12  
(HP) (yield gpm)  
E.L.E.C.  
(type power)  
(7) electric log ~~YES~~ NO  
(yes or no)  
(organization running log)

description of formations encountered	from	to
MED. CLAY	0	8
MED. SD. CLAY	8	25
SD. & CLAY	25	27
CLAY	27	43
F.N. CLEAN SD.	43	50
LOOSE SD.	50	70
CHALK	70	72
"	72	127
"	127	144
YAL. SD.	144	150
"	150	165
MED. COARSE	165	181

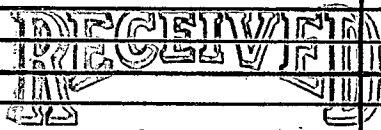


AUG 25 1986

(8) how well bottom plugged SHELL TRAP  
D.W.V. PIPED W/ O.D. 1.75" I.D. 1.5" 10' 0"

DRILLERS REMARKS:

If well telescopes please sketch and show depths.

GROUND LEVEL

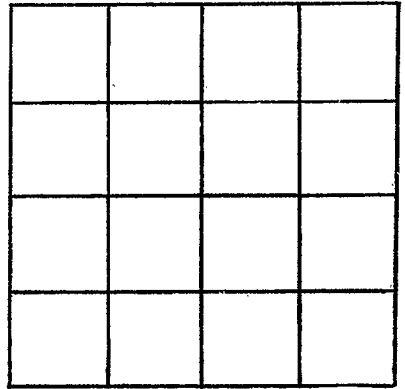

SECTION \_\_\_\_\_

Please indicate well location X.

ADDITIONAL INFORMATION

If more than one screen,  
show locations of each on sketch.