

# MISSISSIPPI DEPARTMENT OF NATURAL RESOURCES

Bureau of Land and Water Resources

COUNTY WELL LOCATED <b>WAYNE</b>	
WELL NUMBER <b>GT</b>	CODED
DATE WELL COMPLETED <b>8/17/87</b>	

PERMIT NUMBER <b>205</b>
NAME OF DRILLING FIRM <b>CARB'S WELL SERV</b>
<b>BOCKATONNA, MS</b>

P.O. Box 10631  
Jackson, Mississippi 39209  
WATER WELL DRILLERS LOG

NAME & MAILING ADDRESS OF LANDOWNER <b>DAWAN HEAP</b>			
<b>BT. 1 BOX 50 A</b>			
<b>SHUBUTA, MS, 39360</b>			
WELL LOCATION:	SEC	TOWNSHIP	RANGE
	<b>10</b>	<b>9</b>	<b>N 8 E</b>
DISTANCE	DIRECTION	NEAREST TOWN	
<b>5 1/2</b> Miles	<b>N</b>	of <b>WHISLER</b>	
OTHER LANDMARK			
WELL PURPOSE <input checked="" type="radio"/> Home, Irrigation, Municipal, Industrial, Fish Pond, etc.			

PUMP DATA		
PUMP TYPE (Circle One): Submersible, Turbine, <input checked="" type="radio"/> Flowing Well, Other (Describe) _____		
POWER TYPE (Circle One): <input checked="" type="radio"/> Electric, Tractor, Diesel, Gasoline, Butane, Other (Describe) _____		
Pump Capacity (GPM)	No. of Stages	Setting Depth
<b>7</b>	<b>2</b>	<b>100 FT.</b>
PUMP TEST		
Well yielded <b>10 7/8</b> GPM with a drawdown of <b>2 6/8</b> ft. after <b>2 HR.</b> hours of pumping		

WELL DATA		
Well Depth <b>187</b>	Casing Diameter (In.) <b>2 1/2</b>	Casing Length (Ft.) <b>180</b>
Type of Casing <b>PVC, 183</b>	Hole Depth <b>183</b>	Depth to Static Water Level <b>34</b>
TYPE OF COMPLETION: (Circle One or More): Gravel Packed, Underreamed, Telescoped, Natural Development, <input checked="" type="radio"/> Open Hole, Other		
Top of Lap Pipe or Reduction in Casing		
FEET IF TELESCOPED OR MORE THAN ONE SCREEN: USE BACK PAGE		

LOG DATA	
TYPE OF LOG RUN (Circle One): No Log Run, Electric, Gamma Ray, Density, Sonic, Neutron, Other (Describe) _____	
Name of Organization Running Log	

SCREEN DATA		
Diameter - Inches	Length - Feet	Slot Size - Inches
Screen Type <b>OPEN</b>	Depth to Bottom - Feet	

GEOLOGIC DATA (Office Use Only)			
Surface Elev.	Geologic Unit	Unit Thickness	Depth to Top
Subs. SWL	Date	Analysis	Aquifer Test

Driller's Remarks <b>PISSSED BACK WASH VALVE</b>
---


DESCRIPTION OF FORMATIONS ENCOUNTERED	FROM	TO	FORMATIONS (Continued)	FROM	TO
TOP SOIL	0	1	<b>RECEIVED</b>	90	90
RED CLAY	1	15	<b>CLAY</b>	90	105
SD + CLAY	15	21	<b>ROCK STRATOR</b>	105	115
MOSTLY CLAY	21	42	<b>BLUE CLAY</b>	115	153
SAND	42	55	<b>ROCK STRATOR</b>	153	182
CLAY	55	60			
SAND	60	65			
ROCK	65				
BLUE CLAY	65	80			
THIN ROCK	80				
CLAY	80	87			

IF MORE SPACE IS NEEDED, USE BACK

If well telescopes please  
sketch and show depths.

---

GROUND LEVEL

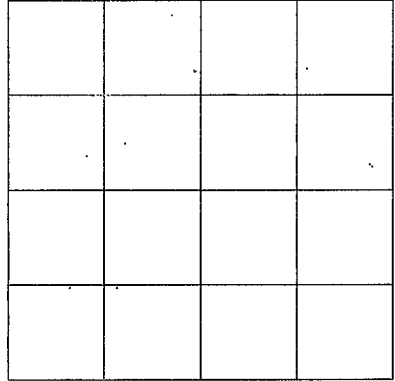

SECTION \_\_\_\_\_

Please indicate well location X.

---

ADDITIONAL INFORMATION

---

If more than one screen,  
show location of each on sketch.