

WAYNE

B G 2057

4-7-78

MISSISSIPPI
BOARD OF WATER COMMISSIONERS
416 North State Street
Jackson, Mississippi 39201

WATER WELL DRILLERS LOG

April 7

19 *ME* **NEWAIN WATER WELL SERVICE** *Wayne*

date well completed

RT. 8 *Box 32*

county well located

WAYNESBORO, MISS 39367

LANDOWNER:

Gary Miller

Shubetta, Miss
(mailing address)

description of formations encountered

from

to

Red Sandy Clay

0

10

Sand + Pea Gravel

10

105

WELL LOCATION:

sec. 3 T. 9 N R. 8 E
6 miles SE of ENCETTA
(distance) (direction) (nearest town)

Yellow Clay

105

110

Blue Clay

110

115

WELL PURPOSE: Home
(home, irrigation, municipal, industrial)

Rock + Gumy Clay

115

125

WELL COMPLETION DATA:

Brown Clay

125

170

(1) diameter (inches) 2"

Honey Comb Rock

170

207

(2) total depth (feet) 207'

(3) static water level (feet) 133' below above top of ground.

(4) casing PVC 170'
(material) (depth)

2"
(size) if telescope see back.

(5) screen _____
(length) (depth to top)

(size) (material)

(6) pump 2 5
(HP) (yield gpm)

220 AC
(type power)

(7) electric log No
(yes or no)

(organization running log)

(8) how well bottom plugged _____


DRILLERS REMARKS:

RECEIVED
APR 24 1978

MISS. BD. OF WATER COMM.

If well telescopes please sketch and show depths.

GROUND LEVEL

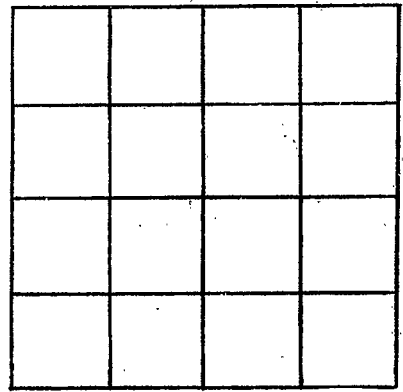

SECTION _____

Please indicate well location X.

ADDITIONAL INFORMATION

A series of horizontal lines for recording additional information, starting below the 'ADDITIONAL INFORMATION' header and extending to the bottom of the page.

If more than one screen, show locations of each on sketch.

