

H8

9-2-63

WATER WELL DRILLERS LOG

Date: Sept 2, 1963, Driller: Bonted Drilling & Log County Wayne
(Name)
 3P


(1) Owner of Land: <u>Antioch Assoc. of God</u> <small>(Name)</small>	Description & Color of Materials Sand, Clay, Red Clay, Shell, etc.	Thick- ness Feet	Depth Feet
<u>Rt 1 Magneshoro</u> <small>(Address)</small>	<u>red clay</u>	<u>14</u>	<u>14</u>
	<u>red sand</u>	<u>16</u>	<u>30</u>
(2) Location: <u>SE 1/4, NE 1/4, Sec 29 T9R7</u>	<u>sand & chalk</u>	<u>20</u>	<u>50</u>
<u>4 1/2</u> miles <u>NW</u> , of <u>Magneshoro</u> , <small>(distance) (direction) (Nearest Town)</small>	<u>white sand</u>	<u>10</u>	<u>60</u>
(3) Topography: <u>hilly</u> <small>(Hilly) (Flat) (Level)</small>			
(4) Purpose of Well: <u>domestic</u> <small>(Domestic Irrigation Municipal, Industrial, Other)</small>			

Information upon completion of well:

- (1) Diameter 2" inches.
- (2) Total Depth 60' feet.
- (3) Water Level 32' feet below top of ground.
- (4) Cased to 53', Size 2"
- (5) Screen: Size 1 1/4", Length 6'
- (6) Were any formations sealed against pollution?
 yes, no.

If YES depth of formation: _____
 Why _____

Drillers Remarks: 1/2 HP Jet

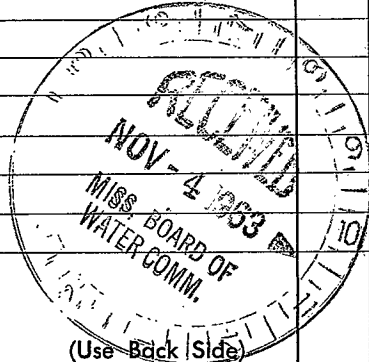

Well No.

