

H 14

10-12-63

WATER WELL DRILLERS LOG

Date: Oct 12, 1963, Driller: Porter Drilling & Pipe Co. Wayne
 3P (Name)

(1) Owner of Land: <u>Noland Clark</u> (Name)	Description & Color of Materials Sand, Clay, Red Clay, Shell, etc.	Thick- ness Feet	Depth Feet
<u>Rt 1 Waynesboro</u> (Address)	<u>sand</u>	29	29
(2) Location: <u>NW 1/4, NW 1/4, Sec. 35 T9 R7</u>	<u>blue chalk</u>	11	40
<u>3</u> miles <u>NW</u> of <u>Waynesboro</u> (distance) (direction) (Nearest Town)	<u>limestone rock</u>	6	46
(3) Topography: <u>flat</u> (Hilly) (Flat) (Level)			
(4) Purpose of Well: <u>domestic</u> (Domestic Irrigation Municipal, Industrial, Other)			


Information upon completion of well:

- (1) Diameter 2" inches.
- (2) Total Depth 46' feet.
- (3) Water Level 29' feet below top of ground.
- (4) Cased to 40', Size 2"
- (5) Screen: Size none, Length _____
- (6) Were any formations sealed against pollution?
 _____ yes, no.

If YES depth of formation _____

Why _____

Drillers Remarks: _____

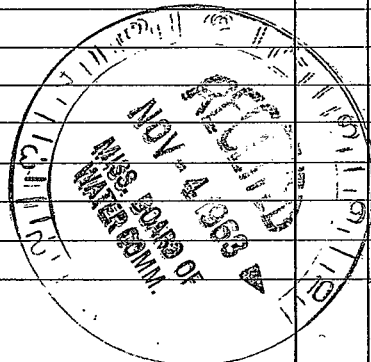

(Use Back Side)

Well No. _____

