

WAYNE MISSISSIPPI BOARD OF WATER COMMISSIONERS

H 15

10-27-63

WATER WELL DRILLERS LOG

Date: Oct 27, 19 63, Driller: Porter Drilling & Pipe County Wayne
(Name)

(1) Owner of Land	Description & Color of Materials Sand, Clay, Red Clay, Shell, etc.	Thick- ness Feet	Depth Feet
<u>State J. Williams</u> <small>(Name)</small>	<u>red clay</u>	<u>10</u>	<u>10</u>
<u>At 1 Waynesboro, Miss</u> <small>(Address)</small>	<u>red sand</u>	<u>15</u>	<u>35</u>
(2) Location: <u>NW 1/4, NW 1/4, Sec 33 T. 9 R. 7</u>	<u>yellow sand & chalk</u>	<u>16</u>	<u>51</u>
<u>4</u> miles <u>NW</u> of <u>Waynesboro</u> <small>(distance) (direction) (Nearest Town)</small>	<u>sand rock & sand</u>	<u>4</u>	<u>55</u>
(3) Topography: <u>Hilly</u> <small>(Hilly) (Flat) (Level)</small>	<u>med. sand & chalk</u>	<u>13</u>	<u>68</u>
(4) Purpose of Well: <u>domestic</u> <small>(Domestic Irrigation Municipal, Industrial, Other)</small>	<u>course sand</u>	<u>2</u>	<u>70</u>

Information upon completion of well:

(1) Diameter 2" inches.

(2) Total Depth 70' feet.

(3) Water Level 49' feet below top of ground.

(4) Cased to 64', Size 2"


(5) Screen: Size 1 1/4", Length 6'

(6) Were any formations sealed against pollution?
 _____ yes, X no.

If YES depth of formation _____

Why _____

Drillers Remarks: _____

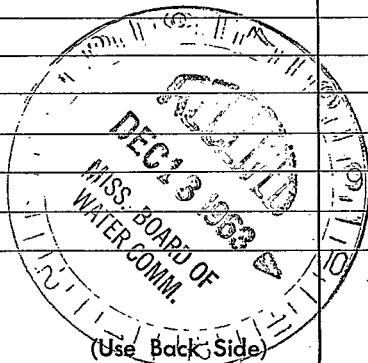

Well No. _____

