

# WAYNE MISSISSIPPI BOARD OF WATER COMMISSIONERS

H 16

2-29-64

## WATER WELL DRILLERS LOG

Date: Feb. 29, 1964, Driller: Porter Drilling & Log County Wayne  
3P (Name)

(1) Owner of Land: George Bugh  
(Name)  
Rt 1 Waynesboro  
(Address)

(2) Location: SW 1/4, SE 1/4, Sec. 8 T9 R7  
6 miles N.W. of Waynesboro  
(distance) (direction) (Nearest Town)

(3) Topography: Hilly  
(Hilly) (Flat) (Level)

(4) Purpose of Well: Domestic  
(Domestic Irrigation Municipal, Industrial, Other)

Description & Color of Materials Sand, Clay, Red Clay, Shell, etc.	Thick-ness Feet	Depth Feet
<u>red clay</u>	10	10
<u>red sand</u>	42	52
<u>med white sand</u>	14	66
<u>stopped on cherts</u>		

### Information upon completion of well:

(1) Diameter 2" inches.

(2) Total Depth 66' feet.

(3) Water Level 46' feet below top of ground.

(4) Cased to 60', Size 2" copper.


(5) Screen: Size 1 1/4", Length 5'  
Johman S.S

(6) Were any formations sealed against pollution?  
 yes,  no.

If YES depth of formation \_\_\_\_\_

Why \_\_\_\_\_

Drillers Remarks: \_\_\_\_\_

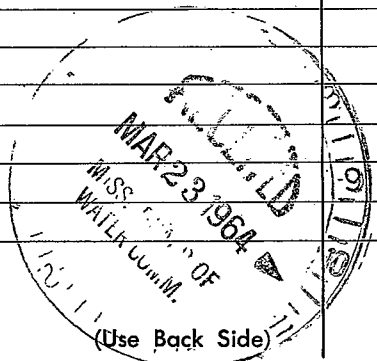

Well No. \_\_\_\_\_

Mail this copy to Board of Water Commissioners 429 Miss. St. Jackson, Miss

