

WAYNE MISSISSIPPI BOARD OF WATER COMMISSIONERS

H17

7-29-63

WATER WELL DRILLERS LOG

Date: July 29, 1963, Driller: Porter Drilling & Pump County Wayne
(Name)


(1) Owner of Land: Marshal Sadeby
(Name)
At 1 Waynesboro, Miss
(Address)
 (2) Location: NE 1/4, SE 1/4, Sec. 8 T. 9 R. 7,
7 miles NW of Waynesboro
(distance) (direction) (Nearest Town)
 (3) Topography: Hilly
(Hilly) (Flat) (Level)
 (4) Purpose of Well: domestic
(Domestic Irrigation
 Municipal, Industrial, Other)

| Description & Color of Materials Sand, Clay, Red Clay, Shell, etc. | Thick- ness Feet | Depth Feet |
|-----------------------------------------------------------------------|------------------------|---------------|
| <u>red clay</u> | <u>15</u> | <u>15</u> |
| <u>sand</u> | <u>50</u> | <u>65</u> |
| <u>course sand some</u> | | |
| <u>pea gravel</u> | <u>10</u> | <u>75</u> |
| <u>chalk mixed with</u> | | |
| <u>a little sand</u> | <u>5</u> | <u>80</u> |

Information upon completion of well:

(1) Diameter 2' inches.
 (2) Total Depth 75' feet.
 (3) Water Level 69' feet below top of ground.
 (4) Cased to 71', Size 2"
 (5) Screen: Size 2", Length 4'
 (6) Were any formations sealed against pollution?
 _____ yes, X no.

If YES depth of formation _____
 Why _____
 Drillers Remarks: _____

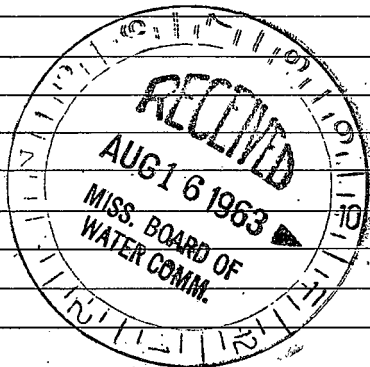

(Use Back Side)

Well No.

