

H 18

7-31-63

WATER WELL DRILLERS LOG

Date: July 31, 1963, Driller: Porter Drilling & Pump Co. County: Wayne

(1) Owner of Land: Harold Graham

Box 1 Waynesboro

(2) Location: SW 1/4, SW 1/4, Sec. 8 T9R7

7 miles NW of Waynesboro

(3) Topography: hilly

(4) Purpose of Well: domestic

Table with 3 columns: Description & Color of Materials, Thickness Feet, Depth Feet. Rows include red clay, red sand, fine sand, coarse white sand, black sand rock, Chalk.

Information upon completion of well:

(1) Diameter 2' inches.

(2) Total Depth 50' feet.

(3) Water Level 37' feet below top of ground.

(4) Cased to 45', Size 2' copper.


(5) Screen: Size 5/16", Length 5' S.S.

(6) Were any formations sealed against pollution? yes, X no.

If YES depth of formation

Why

Drillers Remarks:

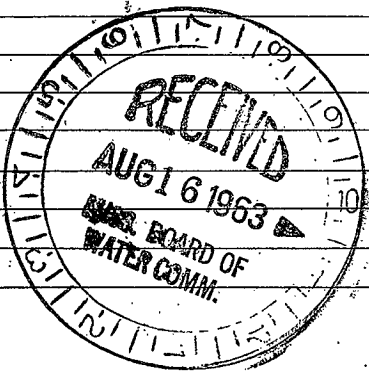

(Use Back Side)

Well No.

