

WAYNE
H 19
5-11-63

MISSISSIPPI BOARD OF WATER COMMISSIONERS

WATER WELL DRILLERS LOG


Date: May 11, 1963, Driller: Porter Drilling & Log Co. Wayne
37 (Name)

(1) Owner of Land: Ceala Reynolds
(Name)
Rt 4 Waynesboro
(Address)
(2) Location: NE 1/4, SW 1/4, Sec. 24 T9 R 7,
4 1/2 miles north of Waynesboro,
(distance) (direction) (Nearest Town)
(3) Topography: hilly
(Hilly) (Flat) (Level)
(4) Purpose of Well: domestic
(Domestic Irrigation
Municipal, Industrial, Other)

Description & Color of Materials Sand, Clay, Red Clay, Shell, etc.	Thick- ness Feet	Depth Feet
<u>red clay</u>	<u>15</u>	<u>15</u>
<u>rock</u>	<u>10</u>	<u>25</u>
<u>white chert</u>	<u>25</u>	<u>50</u>
<u>rock</u>	<u>5</u>	<u>55</u>
<u>white chert</u>	<u>5</u>	<u>60</u>
<u>rock</u>	<u>2</u>	<u>62</u>
<u>sand fine</u>	<u>12</u>	<u>74</u>

Information upon completion of well:

(1) Diameter 2' inches.
(2) Total Depth 74' feet.
(3) Water Level 24' feet below top of ground.
(4) Cased to 65 1/2', Size 2"
(5) Screen: Size 1 1/4", Length 6'
(6) Were any formations sealed against pollution?
_____ yes, X no.

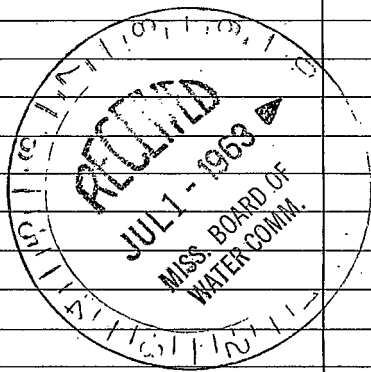

If YES depth of formation _____
Why _____
Drillers Remarks: _____

(Use Back Side)

Well No.

