

WAYNE

MISSISSIPPI BOARD OF WATER COMMISSIONERS

H 20

5-3-61

WATER WELL DRILLERS LOG

7-302

Date: May 3, 1961, Driller: D. N. Porter & Son County Wayne
(Name)


- (1) Owner of Land: George Rainwater
(Name)
Rt 4 Waynesboro, Miss.
(Address)
- (2) Location: NE 1/4, SE 1/4, Sec. 14 T9R7,
_____ miles _____ of Boyce,
(distance) (direction) (Nearest Town)
- (3) Topography: flat
(Hilly) (Flat) (Level)
- (4) Purpose of Well: domestic
(Domestic Irrigation
Municipal, Industrial, Other)

| Description & Color of Materials Sand, Clay, Red Clay, Shell, etc. | Thick- ness Feet | Depth Feet |
|---|------------------------|---------------|
| clay | 12' | 12' |
| sand | 21' | 33' |

Information upon completion of well:

- (1) Diameter 2" inches.
- (2) Total Depth 33 feet.
- (3) Water Level 18' feet below top of ground.
- (4) Cased to 28', Size 2"
- (5) Screen: Size 1 1/4", Length 5'
- (6) Were any formations sealed against pollution?
_____ yes, no.

If YES depth of formation _____
Why _____
Drillers Remarks: _____

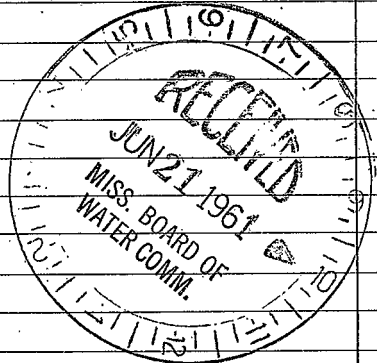

(Use Back Side)

Well No.

