

WAYNE MISSISSIPPI BOARD OF WATER COMMISSIONERS

H24

3-7-63

WATER WELL DRILLERS LOG


Date: March 7, 1963, Driller: Boate Drilling & Log Co County Wayne
 3P (Name)

(1) Owner of Land: Gerry Langley
 (Name)
Box 1 Waynesboro
 (Address)
 (2) Location: NW 1/4, SE 1/4, Sec 31 T9R7
6 miles west of Waynesboro
 (distance) (direction) (Nearest Town)
 (3) Topography: Hilly
 (Hilly) (Flat) (Level)
 (4) Purpose of Well: domestic
 (Domestic Irrigation
 Municipal, Industrial, Other)

Description & Color of Materials Sand, Clay, Red Clay, Shell, etc.	Thick- ness Feet	Depth Feet
<u>red clay</u>	<u>20</u>	<u>20</u>
<u>sand + chert</u>	<u>60</u>	<u>85</u>
<u>sand</u>	<u>41</u>	<u>126</u>
<u>stopped while</u>		
<u>still in course east</u>		

Information upon completion of well:

(1) Diameter: 2" inches.
 (2) Total Depth: 125' feet.
 (3) Water Level: 114' feet below top of ground.
 (4) Cased to: 119', Size 2"
 (5) Screen: Size 1 1/4", Length 6'
60 ga
 (6) Were any formations sealed against pollution?
 _____ yes, X no.

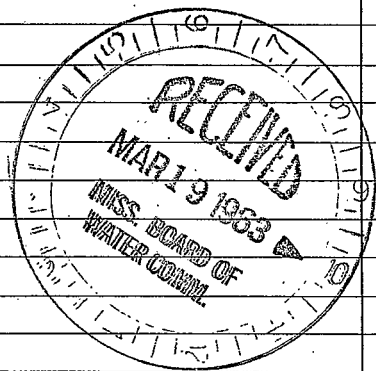

If YES depth of formation _____

Why _____

Drillers Remarks: _____

(Use Back Side)

Well No.

