

WAYNE MISSISSIPPI BOARD OF WATER COMMISSIONERS

H 25

4-9-63

WATER WELL DRILLERS LOG

Date: April 9, 1963, Driller: Porter Drilling & Pipe County Wayne  
 3P (Name)


(1) Owner of Land: Blotch, Rhinehat  
 (Name)  
At 4 Wagnersboro  
 (Address)  
 (2) Location SW 1/4, NE 1/4, Sec. 36 T.9.R.7.  
2 miles north of Wagnersboro,  
 (distance) (direction) (Nearest Town)  
 (3) Topography: Hilly  
 (Hilly) (Flat) (Level)  
 (4) Purpose of Well: domestic  
 (Domestic Irrigation  
 Municipal, Industrial, Other)

Description & Color of Materials Sand, Clay, Red Clay, Shell, etc.	Thick- ness Feet	Depth Feet
<u>red clay</u>	<u>14</u>	<u>14</u>
<u>sand</u>	<u>5</u>	<u>19</u>
<u>blue chalk</u>	<u>13</u>	<u>32</u>
<u>stratum of lime rock</u>		
<u>&amp; blue chalk</u>	<u>26</u>	<u>58</u>
<u>blue chalk</u>	<u>14</u>	<u>72</u>
<u>course grey sand</u>	<u>15</u>	<u>87</u>
<u>stoped on blue chalk</u>		

Information upon completion of well:

(1) Diameter 2' inches.  
 (2) Total Depth 87' feet.  
 (3) Water Level 74' feet below top of ground.  
 (4) Cased to 81', Size 2" copper.  
 (5) Screen: Size 1/4", Length 5'.  
John S. S.  
 (6) Were any formations sealed against pollution?  
 \_\_\_\_\_ yes, X no.

If YES depth of formation \_\_\_\_\_  
 Why \_\_\_\_\_  
 Drillers Remarks: \_\_\_\_\_

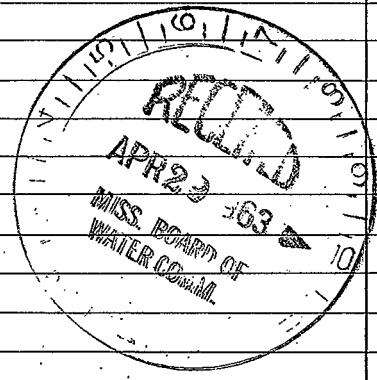

(Use Back Side)

Well No.

