

WAYNE MISSISSIPPI BOARD OF WATER COMMISSIONERS

H-77041


11-20-61

WATER WELL DRILLERS LOG

H

Date: Nov 20, 1961, Driller: S. N. Porter & Son County Wayne
 (Name)

(1) Owner of Land: <u>Noland Clark</u> (Name)	Description & Color of Materials Sand, Clay, Red Clay, Shell, etc.	Thick- ness Feet	Depth Feet
<u>Waynesboro Miss.</u> (Address)	<u>Clay</u>	<u>9</u>	<u>9</u>
(2) Location: <u>SE 1/4, SE 1/4, Sec 36 T9 R7,</u>	<u>rock</u>	<u>3</u>	<u>12</u>
<u>1</u> miles <u>N.</u> of <u>Waynesboro</u> (distance) (direction) (Nearest Town)	<u>rock & blue chalk</u>	<u>16</u>	<u>28</u>
(3) Topography: <u>Hilly</u> (Hilly) (Flat) (Level)	<u>grey sand</u>	<u>25</u>	<u>53</u>
(4) Purpose of Well: <u>domestic</u> (Domestic Irrigation Municipal, Industrial, Other)			
Information upon completion of well:			
(1) Diameter <u>2"</u> inches.			
(2) Total Depth <u>53'</u> feet.			
(3) Water Level <u>33'</u> feet below top of ground.			
(4) Cased to <u>47'</u> , Size <u>2"</u>			
(5) Screen: Size <u>1 1/4"</u> , Length <u>6'</u>			
(6) Were any formations sealed against pollution?			
<u> </u> yes, <u>X</u> no.			
If YES depth of formation _____			
Why _____			
Drillers Remarks: _____			

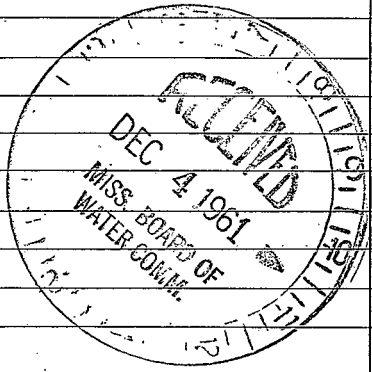

(Use Back Side)

Well No.

