

WAYNE

MISSISSIPPI BOARD OF WATER COMMISSIONERS

H28

4-11-62

WATER WELL DRILLERS LOG

Date: April 11, 1962, Driller: Porter Drilling & Sup. County: Wayne

(Name)

(1) Owner of Land: Roland Clark (Name)	Description & Color of Materials Sand, Clay, Red Clay, Shell, etc.	Thick- ness Feet	Depth Feet
Waynesboro Miss (Address)	red clay strata lime rock & blue chalk	18	18'
(2) Location: SE 1/4, NE 1/4, Sec. 36 T9 R7, 1 1/2 miles N. of Waynesboro, (distance) (direction) (Nearest Town)	blue chalk lime rock blue chalk & strata of rock	12' 8 3 14	30 38 41 55
(3) Topography: hilly (Hilly) (Fch) (Level)	rock blue chalk	6 2	61 63
(4) Purpose of Well: domestic (Domestic Irrigation Municipal, Industrial, Other)	blue sand	18	81

Information upon completion of well:


- (1) Diameter 2" inches.
- (2) Total Depth 81' feet.
- (3) Water Level 60 feet below top of ground.
- (4) Cased to 75', Size 2"
- (5) Screen: Size 1 1/4", Length 6'
- (6) Were any formations sealed against pollution?

yes, X no.

If YES depth of formation \_\_\_\_\_

Why \_\_\_\_\_

Drillers Remarks: \_\_\_\_\_

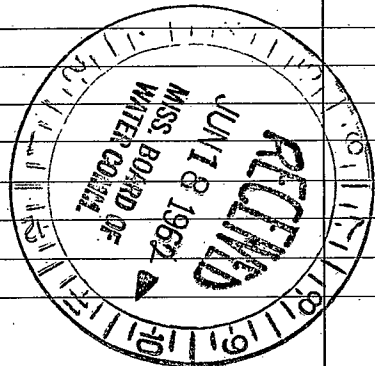

(Use Back Side)

Well No.

