

H 29

4-12-62

WATER WELL DRILLERS LOG

Date April 12, 1962, Driller Porter Drilling & Sup. County Wayne
 (Name)

(1) Owner of Land:	Description & Color of Materials Sand, Clay, Red Clay, Shell, etc.	Thick- ness Feet	Depth Feet
<u>Noland Clark</u> (Name) <u>Waynesboro Miss</u> (Address)	<u>Stiff red clay</u> <u>strata of lime fossils</u>	<u>15'</u>	<u>15'</u>
(2) Location <u>SW 1/4, NE 1/4, Sec. 36 T9R7</u> <u>1 1/2</u> miles <u>N</u> of <u>Waynesboro</u> (distance) (direction) (Nearest Town)	<u>to blue chalk</u> <u>blue sand</u> <u>stopped on chalk</u>	<u>23</u> <u>18</u>	<u>38</u> <u>56</u> <u>56'</u>
(3) Topography: <u>hilly</u> (Hilly) (Flat) (Level)			
(4) Purpose of Well: <u>domestic</u> (Domestic Irrigation Municipal, Industrial, Other)			

Information upon completion of well:


- (1) Diameter 2" inches.
- (2) Total Depth 56' feet.
- (3) Water Level 40' feet below top of ground.
- (4) Cased to 50', Size 2"
- (5) Screen: Size 1 1/4", Length 6'
- (6) Were any formations sealed against pollution?

_____ yes, no.

If YES depth of formation _____

Why _____

Drillers Remarks: _____

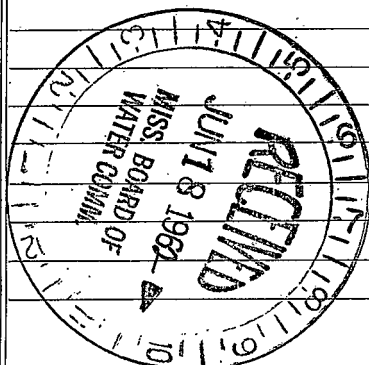

(Use Back Side)

Well No. _____

