

WAYNE

MISSISSIPPI BOARD OF WATER COMMISSIONERS

H31

5-4-62

WATER WELL DRILLERS LOG

Date: May 4, 1962, Driller: Porter Drilling & Exp. Co., Wayne County, Wayne

(1) Owner of Land: Romey Reynolds  
 (Name)  
Rt 1 Waynesboro  
 (Address)

(2) Location: SW 1/4, SW 1/4, Sec 33 T9 R7  
3 1/2 miles west of Waynesboro  
 (distance) (direction) (Nearest Town)

(3) Topography: Hilly  
 (Hilly) (Flat) (Level)

(4) Purpose of Well: domestic  
 (Domestic Irrigation  
 Municipal, Industrial, Other)

| Description & Color of Materials<br>Sand, Clay, Red Clay, Shell, etc. | Thick-<br>ness<br>Feet | Depth<br>Feet |
|---|------------------------|---------------|
| <u>red clay</u>   | <u>20</u>              | <u>20</u>     |
| <u>red sand, frijied<br/>with chalk</u>                               | <u>22</u>              | <u>42</u>     |
| <u>red chalk</u>  | <u>5</u>               | <u>47</u>     |
| <u>blue sand with chalk</u>   | <u>5</u>               | <u>52</u>     |
| <u>stayed on chalk</u>  |                        | <u>52'</u>    |

Information upon completion of well:

(1) Diameter 2" inches.

(2) Total Depth 52' feet.

(3) Water Level 34 feet below top of ground.

(4) Cased to 47, Size 2"

(5) Screen: Size 1 1/4, Length 6'


(6) Were any formations sealed against pollution?

yes, X no.

If YES depth of formation \_\_\_\_\_

Why \_\_\_\_\_

Drillers Remarks: \_\_\_\_\_

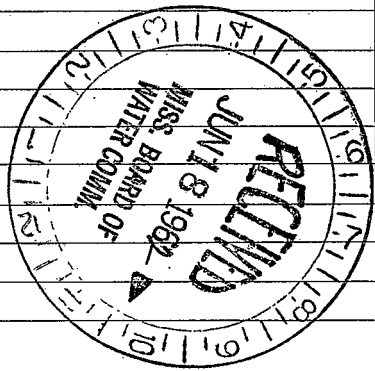

(Use Back Side)

Well No.

