

WAYNE

MISSISSIPPI BOARD OF WATER COMMISSIONERS

H32

5-25-62

WATER WELL DRILLERS LOG

Date: May 25, 1962, Driller: Porter Drilling Co County Wayne
(Name)

(1) Owner of Land:	Description & Color of Materials Sand, Clay, Red Clay, Shell, etc.	Thick- ness Feet	Depth Feet
<u>Robert Mark Fitzgerald</u> (Name)	<u>red clay</u>	<u>12</u>	<u>12</u>
<u>Rt 1 Waynesboro</u> (Address)	<u>stiff chert</u>	<u>16</u>	<u>28</u>
(2) Location: <u>NW 1/4, SE 1/4, Sec. 33 T9 R7</u>	<u>sand</u>	<u>11</u>	<u>39</u>
<u>3</u> miles <u>NW</u> of <u>Waynesboro</u> (distance) (direction) (Nearest Town)	<u>sand to chert</u>	<u>6</u>	<u>45</u>
	<u>stopped on chert</u>		
(3) Topography: <u>hilly</u> (Hilly) (Flat) (Level)			
(4) Purpose of Well: <u>domestic</u> (Domestic Irrigation Municipal, Industrial, Other)			

Information upon completion of well:

(1) Diameter 2" inches.

(2) Total Depth 39' feet.

(3) Water Level 25' feet below top of ground.

(4) Cased to 33', Size 2"

(5) Screen: Size 1 1/4", Length 6'


(6) Were any formations sealed against pollution?

_____ yes, X no.

If YES depth of formation _____

Why _____

Drillers Remarks: _____

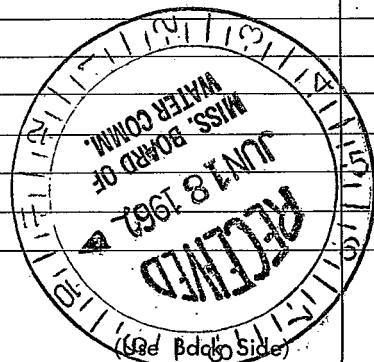

Well No.

