

WAYNE MISSISSIPPI BOARD OF WATER COMMISSIONERS

H37

12-9-63

WATER WELL DRILLERS LOG

Date: Dec 9, 1963, Driller: Porter Drilling & Log Co County Wayne
 (Name)


(1) Owner of Land	Description & Color of Materials Sand, Clay, Red Clay, Shell, etc.	Thick- ness Feet	Depth Feet
<u>Annie V. Whitfield</u> (Name)	<u>red clay</u>	6	6
<u>Rt 4 Waynesboro, Miss</u> (Address)	<u>sand & gravel</u>	9	15
(2) Location: <u>SE 1/4, SE 1/4, Sec. 11 T9R7</u>	<u>chals</u>	6	21
<u>5</u> miles <u>west</u> , of <u>Waynesboro</u> (distance) (direction) (Nearest Town)	<u>red sand</u>	11	32
(3) Topography: <u>hilly</u> (Hilly) (Flat) (Level)	<u>chals</u>	2	34
(4) Purpose of Well: <u>domestic</u> (Domestic Irrigation Municipal, Industrial, Other)	<u>fine clean sand</u>	6	40
	<u>sand to chals</u>	2	42

Information upon completion of well:

- (1) Diameter 2" inches.
- (2) Total Depth 40' feet.
- (3) Water Level 27' feet below top of ground.
- (4) Cased to 36', Size 2"
- (5) Screen: Size 2", Length 4'
- (6) Were any formations sealed against pollution?
 _____ yes, X no.

If YES depth of formation _____
 Why _____

Drillers Remarks: _____

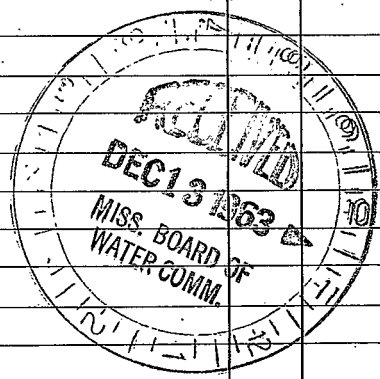

Well No.

(Use Back Side)

