

WAYNE MISSISSIPPI BOARD OF WATER COMMISSIONERS

H 38

12-29-63

WATER WELL DRILLERS LOG

Date: Dec 29, 1963, Driller: Booth Drilling & Log County Wayne  
 (Name)

- (1) Owner of Land: Jacob William  
 (Name)  
Rt 1 Haynesboro  
 (Address)
- (2) Location: NW 1/4, SE 1/4, Sec. 32 T9 R7  
5 miles west, of Haynesboro  
 (distance) (direction) (Nearest Town)
- (3) Topography: Hilly  
 (Hilly) (Flat) (Level)
- (4) Purpose of Well: domestic  
 (Domestic Irrigation  
 Municipal, Industrial, Other)


Description & Color of Materials Sand, Clay, Red Clay, Shell, etc.	Thick- ness Feet	Depth Feet
<u>red clay</u>	<u>6</u>	<u>6</u>
<u>yellow clays</u>	<u>8</u>	<u>14</u>
<u>sand + shells</u>	<u>36</u>	<u>50</u>
<u>red sand</u>	<u>15</u>	<u>65</u>

Information upon completion of well:

- (1) Diameter 2" inches.
- (2) Total Depth 65' feet.
- (3) Water Level 48' feet below top of ground.
- (4) Cased to 59', Size 2"
- (5) Screen: Size 1 1/4", Length 6'  
60 ga
- (6) Were any formations sealed against pollution?

no yes,  no.

If YES depth of formation \_\_\_\_\_  
 Why \_\_\_\_\_  
 Drillers Remarks: \_\_\_\_\_

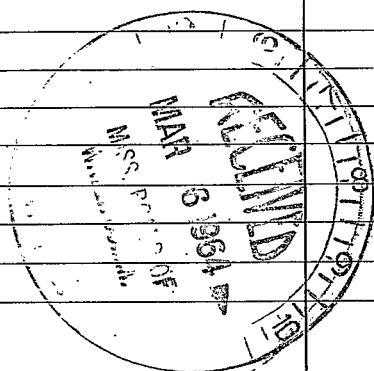

(Use Back Side)

Well No.

