

330
H 40

WATER WELL DRILLERS LOG

11-9-64

Date: Nov 9, 1964, Driller: Porter Drilling & Pipe County Wayne
(Name)

(1) Owner of Land: Bob Norworthy
(Name)
Waynesboro, Miss
(Address)

(2) Location: SW 1/4, SW 1/4, Sec. 26 T7R9,
3 miles NW of Waynesboro
(distance) (direction) (Nearest Town)

(3) Topography: flat
(Hilly) (Flat) (Level)

(4) Purpose of Well: domestic
(Domestic Irrigation
Municipal, Industrial, Other)

Description & Color of Materials Sand, Clay, Red Clay, Shell, etc.	Thick- ness Feet	Depth Feet
<u>red clay</u>	<u>10</u>	<u>10</u>
<u>red sand</u>	<u>11</u>	<u>21</u>
<u>strata of lime rock</u>	<u>18</u>	<u>39</u>
<u>stratified white siliceous rocks</u>		

Information upon completion of well:

(1) Diameter 2'' inches.

(2) Total Depth 39' feet.

(3) Water Level 15' feet below top of ground.


(4) Cased to 26', Size 2''.

(5) Screen: Size none, Length _____.

(6) Were any formations sealed against pollution?
_____ yes, X no.

If YES depth of formation _____
Why _____

Drillers Remarks: _____

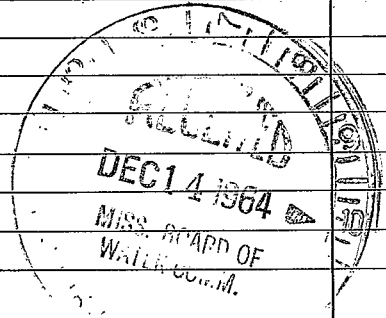

(Use Back Side)

Well No.

