

WAYNE MISSISSIPPI BOARD OF WATER COMMISSIONERS

H 41

3-16-65


WATER WELL DRILLERS LOG

Date: March 16, 1965, Driller: [Signature] Wayne

(1) Owner of Land: Howard Street
(2) Location: NE 1/4, NW 1/4, Sec. 33 T9R7
(3) Topography: Hilly
(4) Purpose of Well: Domestic

Information upon completion of well:
(1) Diameter 2 inches.
(2) Total Depth 57 feet.
(3) Water Level 39 feet below top of ground.
(4) Cased to 51 feet, Size 2 inches.
(5) Screen: Size 1 1/4, Length 6 feet, 60 ga.
(6) Were any formations sealed against pollution? no.

Table with 3 columns: Description & Color of Materials (Sand, Clay, Red Clay, Shell, etc.), Thickness Feet, Depth Feet. Contains handwritten log data.

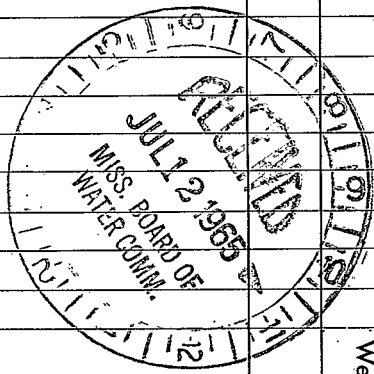

Mail this copy to Board of Water Commissioners 429 Miss. St. Jackson, Miss.

202 11

17

8