

WAYNE

MISSISSIPPI BOARD OF WATER COMMISSIONERS

H 44

7-13-65

WATER WELL DRILLERS LOG

Date: July 13, 1965, Driller: Pat Drilling & Pipe Co., County: Wayne

(Name)

(1) Owner of Land: Marvin Hall
(Name)

Rt 1 Waynesboro, Miss.
(Address)

(2) Location: SW 1/4, SW 1/4, Sec. 33 T. 9 R. 7

4 miles NW of Waynesboro
(distance) (direction) (Nearest Town)

(3) Topography: Hilly
(Hilly) (Flat) (Level)

(4) Purpose of Well: domestic
(Domestic Irrigation
Municipal, Industrial, Other)

Description & Color of Materials Sand, Clay, Red Clay, Shell, etc.	Thick- ness Feet	Depth Feet
<u>red sandy clay</u>	<u>8</u>	<u>8</u>
<u>sand & shells</u>	<u>4.5</u>	<u>53</u>
<u>chalk</u>	<u>4</u>	<u>57</u>
<u>sand</u>	<u>3</u>	<u>60</u>
<u>blue chalk</u>	<u>39</u>	<u>99</u>
<u>rock strata</u>	<u>39</u>	<u>138</u>
<u>130 - 138 hard</u>		
<u>dark blue chalk</u>	<u>33</u>	<u>171</u>
<u>laminar rock</u>	<u>25</u>	<u>196</u>
<u>white chalk</u>	<u>6</u>	<u>202</u>

Information upon completion of well:

(1) Diameter 2" inches.

(2) Total Depth 202 feet.

(3) Water Level 104' feet below top of ground.

(4) Cased to 174', Size 2"


(5) Screen: Size none, Length _____

(6) Were any formations sealed against pollution?
_____ yes, X no.

If YES depth of formation _____

Why _____

Drillers Remarks: _____

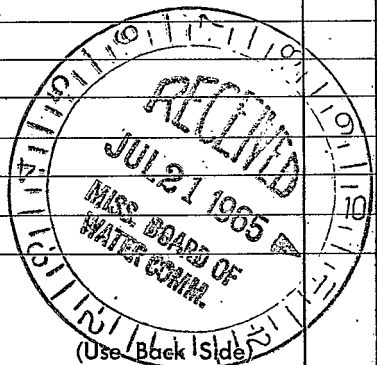

Well No.

