

WAYNE MISSISSIPPI BOARD OF WATER COMMISSIONERS

H 45

8-6-65

WATER WELL DRILLERS LOG

Center Drilling & Exp. Co.
John Rainwater

Date: Aug 6, 1965, Driller: John Rainwater County: Wayne
 (Name)


(1) Owner of Land: John Rainwater
 (Name)
Rt 1 Waynesboro
 (Address)
 (2) Location: NW 1/4, SW 1/4, Sec. 8 T. 9 R. 7
7 miles NW of Waynesboro
 (distance) (direction) (Nearest Town)
 (3) Topography: Hilly
 (Hilly) (Flat) (Level)
 (4) Purpose of Well: domestic
 (Domestic Irrigation
 Municipal, Industrial, Other)

Description & Color of Materials Sand, Clay, Red Clay, Shell, etc.	Thick- ness Feet	Depth Feet
<u>red clay</u>	<u>20</u>	<u>20</u>
<u>red sand</u>	<u>25</u>	<u>45</u>
<u>chert</u>	<u>1</u>	<u>46</u>

Information upon completion of well:

(1) Diameter 2" inches.
 (2) Total Depth 45' feet.
 (3) Water Level 16' feet below top of ground.
 (4) Cased to 40, Size 2" copper.
 (5) Screen: Size 1 1/4, Length 5'.
8 slot Johnson S.S.
 (6) Were any formations sealed against pollution?
 _____ yes, X no.

If YES depth of formation _____
 Why _____
 Drillers Remarks: _____

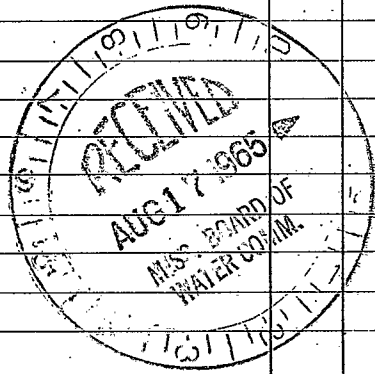

(Use Back Side)

Well No.

