

WAYNE MISSISSIPPI BOARD OF WATER COMMISSIONERS

H46

10-28-65

WATER WELL DRILLERS LOG


Date: Oct 28, 1965, Driller: Porter Drilling & Log County: Wayne
 (Name)

(1) Owner of Land	Description & Color of Materials Sand, Clay, Red Clay, Shell, etc.	Thick- ness Feet	Depth Feet
<u>Lamar Graham</u> (Name)	<u>red clay</u>	<u>12</u>	<u>12</u>
<u>Rt 1 Shubuta Miss</u> (Address)	<u>red sand</u>	<u>53</u>	<u>6.5</u>
(2) Location: <u>SW 1/4, SW 1/4, Sec. 5 T. 9 R. 7</u>	<u>red chalk</u>	<u>5</u>	<u>70</u>
<u>8</u> miles <u>NW</u> of <u>Waynesboro</u> (distance) (direction) (Nearest Town)	<u>blue chalk</u>	<u>20</u>	<u>90</u>
(3) Topography: <u>hilly</u> (Hilly) (Flat) (Level)	<u>thin rock</u>	<u>10</u>	<u>100</u>
(4) Purpose of Well: <u>domestic</u> (Domestic Irrigation Municipal, Industrial, Other)	<u>chalk & sand</u>	<u>37</u>	<u>137</u>
	<u>best circulation</u>	<u>18</u>	<u>155</u>
	<u>honeycombed rock</u>	<u>7</u>	<u>162</u>
	<u>white chalk</u>		

Information upon completion of well:

- (1) Diameter 2" inches.
- (2) Total Depth 162 feet.
- (3) Water Level 111' feet below top of ground.
- (4) Cased to 141', Size 2"
- (5) Screen: Size none, Length _____
- (6) Were any formations sealed against pollution?
 _____ yes, _____ no.

If YES depth of formation _____
 Why _____
 Drillers Remarks: _____

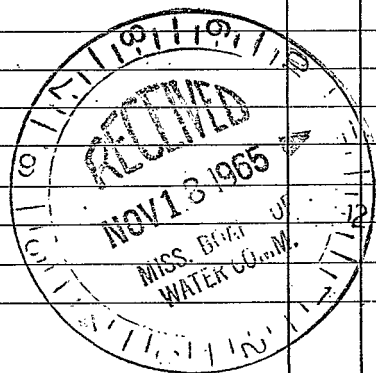

(Use Back Side)

Well No.

