

WAYNE MISSISSIPPI BOARD OF WATER COMMISSIONERS

H48

2-21-66

WATER WELL DRILLERS LOG

Date: Feb 21, 1966, Driller: Porter Drilling Co. County Wayne  
(Name)

(1) Owner of Land:	Description & Color of Materials Sand, Clay, Red Clay, Shell, etc.	Thick- ness Feet	Depth Feet
Hi. May Michael Dawson (Name) Pt 2 Waynesboro (Address)	red clay sand & chert <del>smooth</del>	10 16	10 26
(2) Location: SW 1/4, SE 1/4, Sec. 11 T9R7, 6 miles north, Waynesboro (distance) (direction) (Nearest Town)	mottled sand stopped on chert	10	36
(3) Topography: hilly (Hilly) (Flat) (Level)	2" shale trays above screen		
(4) Purpose of Well: domestic (Domestic Irrigation Municipal, Industrial, Other)			


Information upon completion of well:

- (1) Diameter: 2" inches.
- (2) Total Depth: 36' feet.
- (3) Water Level: 27' feet below top of ground.
- (4) Cased to: 32', Size 2"
- (5) Screen: Size 2', Length 4'  
plastic screen
- (6) Were any formations sealed against pollution?  
 yes,  no.

If YES depth of formation \_\_\_\_\_

Why \_\_\_\_\_

Drillers Remarks: \_\_\_\_\_

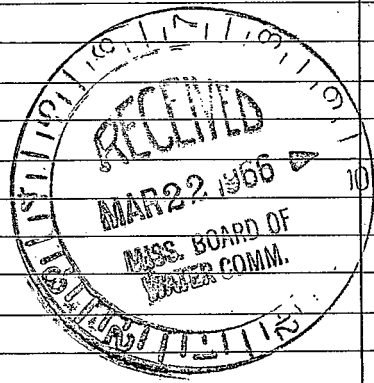

Well No.

(Use Back Side)

