

WAYNE MISSISSIPPI BOARD OF WATER COMMISSIONERS

H 49

3-8-66

WATER WELL DRILLERS LOG

Date: March 8, 1966, Driller: Porter Drilling & Sup. Co. Wayne  
 (Name)

(1) Owner of Land: O. J. Simmons  
 (Name)  
Waynesboro Miss.  
 (Address)

(2) Location: NW 1/4, SE 1/4, Sec. 36 T. 9 R. 7  
1 1/2 miles N of Waynesboro  
 (distance) (direction) (Nearest Town)

(3) Topography: Hilly  
 (Hilly) (Flat) (Level)

(4) Purpose of Well: Domestic  
 (Domestic Irrigation  
 Municipal, Industrial, Other)

Description & Color of Materials Sand, Clay, Red Clay, Shell, etc.	Thick- ness Feet	Depth Feet
<u>red clay</u>	<u>8</u>	<u>8</u>
<u>course sand</u>	<u>10</u>	<u>18</u>
<u>blue chalk</u>	<u>4</u>	<u>22</u>
<u>rock</u>	<u>1</u>	<u>23</u>
<u>blue chalk</u>	<u>6</u>	<u>29</u>
<u>rock strata</u>	<u>36</u>	<u>65</u>
<u>blue chalk</u>	<u>2</u>	<u>67</u>
<u>med sand</u>	<u>18</u>	<u>85</u>
<u>Chalk blue</u>	<u>13</u>	<u>98</u>
<u>limestone rock</u>	<u>34</u>	<u>132</u>

Information upon completion of well:

(1) Diameter 2" inches.

(2) Total Depth 132' feet.

(3) Water Level 76' feet below top of ground.

(4) Cased to 98', Size 2"


(5) Screen: Size none, Length 3 1/2" brk + shale funnel on end of casing

(6) Were any formations sealed against pollution?

X yes, X no.

If YES depth of formation \_\_\_\_\_  
 Why \_\_\_\_\_

Drillers Remarks: \_\_\_\_\_  
 \_\_\_\_\_  
 \_\_\_\_\_

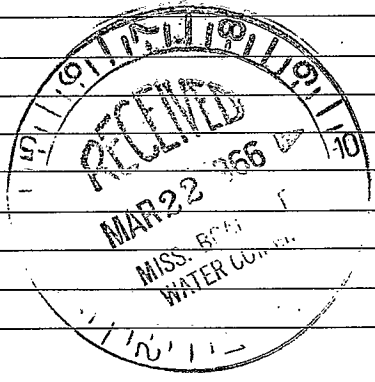

(Use Back Side)

Well No.

