

WAYNE

MISSISSIPPI BOARD OF WATER COMMISSIONERS

H 50

4-22-66

WATER WELL DRILLERS LOG

Date: April 22, 1966, Driller: Porter Drilling Co. County: Wayne

(Name)

(1) Owner of Land: Leroy Langley (Name)

Rt 1 Waynesboro, Miss (Address)

(2) Location: NW 1/4, SE 1/4, Sec. 31 T. 9 R. 7

6 miles west of Waynesboro (distance) (direction) (Nearest Town)

(3) Topography: hilly (Hilly) (Flat) (Level)

(4) Purpose of Well: domestic (Domestic Irrigation Municipal, Industrial, Other)

| Description & Color of Materials Sand, Clay, Red Clay, Shell, etc. | Thick- ness Feet | Depth Feet |
|---|------------------------|---------------|
| red clay | 20 | 20 |
| montmorillonite clay | 16 | 36 |
| sand & chalk | 49 | 85 |
| med sand | 37 | 122 |
| coarse sand & chalk | 4 | 126 |
| pebbles & sand | 6 | 132 |
| stopped on course | | |
| red sand | | |

Information upon completion of well:

(1) Diameter 2" inches.

(2) Total Depth 132' feet.

(3) Water Level 114' feet below top of ground.

(4) Cased to 126', Size 2"

(5) Screen: Size 1 1/4", Length 5' Johnson S.S.


(6) Were any formations sealed against pollution?

yes, X no.

If YES depth of formation

Why

Drillers Remarks:

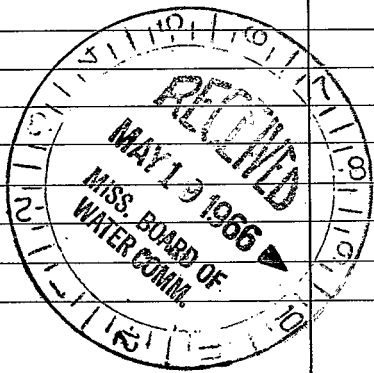

(Use Back Side)

Well No.

