

WAYNE MISSISSIPPI BOARD OF WATER COMMISSIONERS

H 51

5-26-66

WATER WELL DRILLERS LOG

Date: May 26, 1966, Driller: Porter Drilling & Inc. County Wayne
 (Name)


(1) Owner of Land: Mrs Lissie Crum
 (Name)
Rt 4 Magneshoro, Miss
 (Address)
 (2) Location: SW 1/4, NE 1/4, Sec. 25 T. 2 R. 7
3 miles north of Magneshoro
 (distance) (direction) (Nearest Town)
 (3) Topography: Hilly
 (Hilly) (Flat) (Level)
 (4) Purpose of Well: domestic
 (Domestic Irrigation
 Municipal, Industrial, Other)

Description & Color of Materials Sand, Clay, Red Clay, Shell, etc.	Thick- ness Feet	Depth Feet
<u>red clay</u>	<u>12</u>	<u>12</u>
<u>sand</u>	<u>22</u>	<u>34</u>
<u>chalk</u>	<u>8</u>	<u>42</u>
<u>rock strata</u>	<u>20</u>	<u>62</u>
<u>blue chalk</u>	<u>44</u>	<u>106</u>
<u>Wicksburg honeycombed rock</u>	<u>36</u>	<u>142</u>

Information upon completion of well:

(1) Diameter 2" inches.
 (2) Total Depth 142' feet.
 (3) Water Level 111' feet below top of ground.
 (4) Cased to 132', Size 2"
 (5) Screen: Size none used, Length _____
 (6) Were any formations sealed against pollution?
 _____ yes, X no.

If YES depth of formation _____
 Why _____
 Drillers Remarks: _____

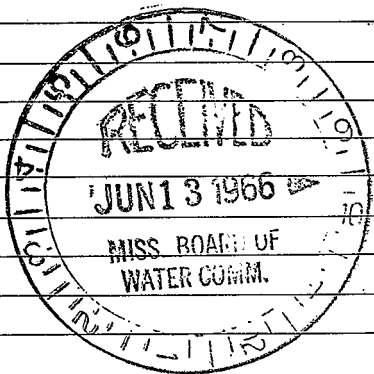

(Use Back Side)

Well No.

