

WAYNE
H 53
6-28-66

MISSISSIPPI BOARD OF WATER COMMISSIONERS

WATER WELL DRILLERS LOG

Date: June 28, 1966, Driller: Garter Drilling & Log County Wayne
(Name)


	Description & Color of Materials Sand, Clay, Red Clay, Shell, etc.	Thick- ness Feet	Depth Feet
(1) Owner of Land: <u>Walter Busby Jr.</u> (Name) <u>Rt 1 Waynesboro, Miss</u> (Address)	<u>sandy clay</u>	<u>8</u>	<u>8</u>
(2) Location: <u>NE 1/4, SW 1/4, Sec. 34 T9R7</u>	<u>sand</u>	<u>15</u>	<u>23</u>
<u>3</u> miles <u>NW</u> of <u>Waynesboro</u> (distance) (direction) (Nearest Town)	<u>chalk</u>	<u>4</u>	<u>27</u>
(3) Topography: <u>hilly</u> (Hilly) (Flat) (Level)	<u>rock</u>	<u>3</u>	<u>30</u>
(4) Purpose of Well: <u>domestic</u> (Domestic Irrigation Municipal, Industrial, Other)	<u>fine blue sand</u>	<u>11</u>	<u>41</u>
	<u>blue chalk</u>	<u>6</u>	<u>47</u>
	<u>rock strata</u>	<u>25</u>	<u>72</u>
	<u>blue chalk</u>	<u>34</u>	<u>106</u>
	<u>honeycom rock</u>		
	<u>Waynesboro Farm</u>	<u>30</u>	<u>136</u>

Information upon completion of well:

- (1) Diameter 2" inches.
- (2) Total Depth 136' feet.
- (3) Water Level 58' feet below top of ground.
- (4) Cased to 105', Size 2"
- (5) Screen: Size none used, Length _____
- (6) Were any formations sealed against pollution?
_____ yes, X no.

If YES depth of formation _____
Why _____

Drillers Remarks: _____

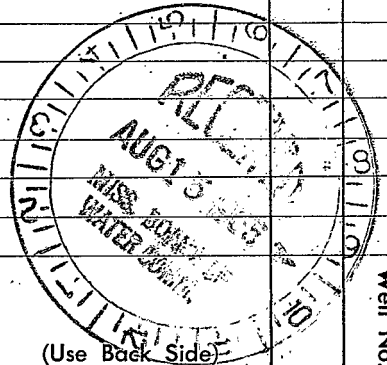

Well No. _____

(Use Back Side)

