

WATER WELL DRILLERS LOG

WAYNE #54

Date: July 13, 1966, Driller: Gator Drilling Co. County: Wayne  
 (Name)

(1) Owner of Land: Wesley Stanley  
 (Name)  
Box 4 Waynesboro  
 (Address)

(2) Location: SW 1/4, SW 1/4, Sec. 11 T9R7  
7 miles N of Waynesboro  
 (distance) (direction) (Nearest Town)

(3) Topography: flat  
 (Hilly) (Flat) (Level)

(4) Purpose of Well: domestic  
 (Domestic Irrigation  
 Municipal, Industrial, Other)

Description & Color of Materials Sand, Clay, Red Clay, Shell, etc.	Thick-ness Feet	Depth Feet
red clay	8	8
sand	7	15
blue chalk	111	126
rock strata	12	138
blue chalk	68	206
rock strata	21	227
sand	5	232
chalk & sand	5	237
clean sand	3	240
rock strata	7 1/2	247 1/2
stayed on chalk		

Information upon completion of well:

(1) Diameter 2" inches.

(2) Total Depth 247' feet.

(3) Water Level small flow feet below top of ground.

(4) Cased to 226', Size 2"


(5) Screen: Size 1 1/4", Length 16'  
80 gu

(6) Were any formations sealed against pollution?  
no

If YES depth of formation \_\_\_\_\_

Why \_\_\_\_\_

Drillers Remarks: \_\_\_\_\_

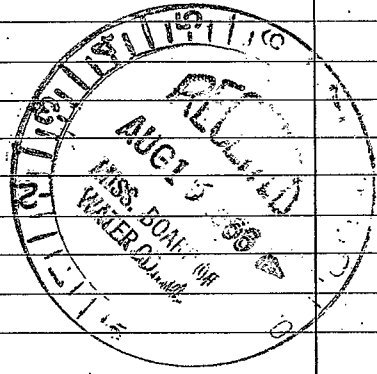

(Use Back Side)

Well No.

