

Wayne
H 55
9-66

MISSISSIPPI BOARD OF WATER COMMISSIONERS

WATER WELL DRILLERS LOG

Date: Sept 8, 1966, Driller: Porter Drilling & Supply County Wayne
(Name)


(1) Owner of Land:	Description & Color of Materials Sand, Clay, Red Clay, Shell, etc.	Thick- ness Feet	Depth Feet
<u>Fletcher Pinchard</u> (Name) <u>Rt 4 Waynesboro</u> (Address)	<u>previously drilled</u>	<u>0-86</u>	<u>0-86</u>
(2) Location: <u>SW 1/4, NE 1/4, Sec. 36 T 9 R 7</u>	<u>blue shell</u>	<u>17</u>	<u>103</u>
<u>2</u> miles, <u>north</u> , of <u>Waynesboro</u> (distance) (direction) (Nearest Town)	<u>Wicksburg Limestone</u> <u>rock</u>	<u>29</u>	<u>132</u>
(3) Topography: <u>hilly</u> (Hilly) (Flat) (Level)			
(4) Purpose of Well: <u>domestic</u> (Domestic Irrigation Municipal, Industrial, Other)			

Information upon completion of well:

- (1) Diameter 2" inches.
- (2) Total Depth 132' feet.
- (3) Water Level 81' feet below top of ground.
- (4) Cased to none, Size 2"
- (5) Screen: Size none, Length _____
- (6) Were any formations sealed against pollution?
_____ yes, X no.

If YES depth of formation _____
Why _____

Drillers Remarks: _____

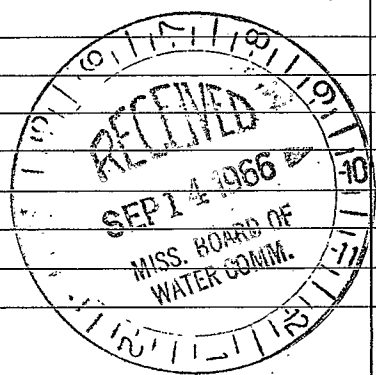

(Use Back Side)

Well No.

100