

Wayne  
H57  
12-66

MISSISSIPPI  
BOARD OF WATER COMMISSIONERS  
416 North State Street  
Jackson, Mississippi 39201

WATER WELL DRILLERS LOG

Dec 21 1966 Porta Drilling & Log Wayne  
date well completed firm name county well located

LANDOWNER:  
Douglas Gray  
Rt 4 Waynesboro Miss  
(mailing address)


description of formations encountered	from	to
<u>red clay + sand</u>	<u>0</u>	<u>38</u>
<u>red sand</u>	<u>38</u>	<u>46</u>
<u>red to white ch. alb</u>	<u>46</u>	<u>49</u>
<u>blue ch. alb</u>	<u>49</u>	<u>55</u>
<u>red silt clay</u>	<u>55</u>	<u>64</u>
<u>blue ch. alb</u>	<u>64</u>	<u>110</u>

WELL LOCATION:  
sec 12 T 9 N R 7 E  
S W  
7 miles N of Waynesboro  
(distance) (direction) (nearest town)

WELL PURPOSE: home  
(home, irrigation, municipal, industrial)

- WELL COMPLETION DATA:
- (1) diameter (inches) 2'
  - (2) total depth (feet) 46'
  - (3) static water level (feet) 35' below above top of ground.
  - (4) casing steel, 42'  
(material) (depth)  
2' if telescope see back.  
(size)
  - (5) screen 3', 43'  
(length) (depth to top)  
1/4, Johnson S.S. 6 slot  
(size) (material)
  - (6) pump 2 HP, 6  
(HP) (yield gpm)  
elec  
(type power)
  - (7) electric log no  
(yes or no)  
(organization running log)
  - (8) how well bottom plugged  
flint point

DRILLERS REMARKS:

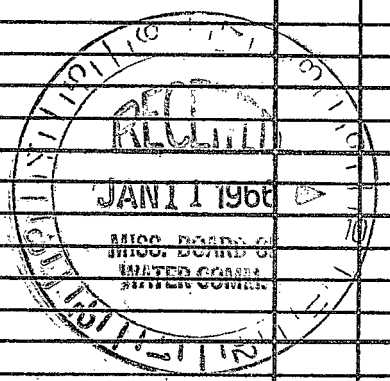

If well telescopes please sketch and show depths.

GROUND LEVEL

42' 2" pipe

3' 1/4 screen  
with 2' 1/4"  
eye pipe tied  
in with packer

		X	

SECTION 12

Please indicate well location X.

ADDITIONAL INFORMATION

If more than one screen, show locations of each on sketch.