

Wayne
H58
1-67

MISSISSIPPI
BOARD OF WATER COMMISSIONERS
416 North State Street
Jackson, Mississippi 39201

WATER WELL DRILLERS LOG

Jan 2 1967 Pontotoc Drilling, Inc. Wayne
date well completed firm name county well located

LANDOWNER:
Allen Bugh
P.O. Box 4 Waynesboro
(mailing address)


description of formations encountered	from	to
	red clay	0
red sand	15	20
clean slightly red sand	20	26
red chalk	26	27

WELL LOCATION:
sec. 12 T. 9 N. R. 7 E.
S W
7 miles N of Waynesboro
(distance) (direction) (nearest town)

WELL PURPOSE:
(home, irrigation, municipal, industrial)


- WELL COMPLETION DATA:
- (1) diameter (inches) 2"
 - (2) total depth (feet) 26'
 - (3) static water level (feet) 15' below top of ground.
 - (4) casing steel, 23' (material) (depth)
2" (size) if telescope see back.
 - (5) screen 3' length, 23' depth to top
1 1/4" (size) Johnson SS 8 shot (material)
 - (6) pump 1/2 HP, 8 1/2 (HP) (yield gpm)
elec (type power)
 - (7) electric log no (yes or no)
(organization running log)
 - (8) how well bottom plugged
flush point

DRILLERS REMARKS:
screen secured on pipe with shell found below

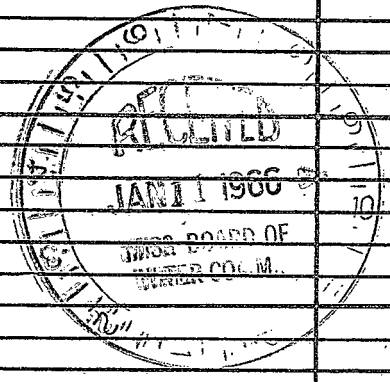

If well telescopes please sketch and show depths.

GROUND LEVEL

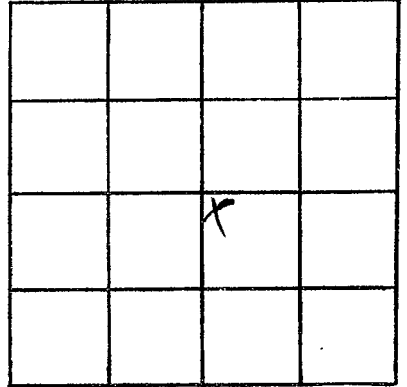

SECTION 12

Please indicate well location X.

ADDITIONAL INFORMATION

If more than one screen, show locations of each on sketch.