

Wayne
H 60
1-67

MISSISSIPPI
BOARD OF WATER COMMISSIONERS
416 North State Street
Jackson, Mississippi 39201

WATER WELL DRILLERS LOG

Jan 6 1967 Porter Drilling & Log Wayne
date well completed firm name county well located


LANDOWNER:
Morgan Gray
Rt 4 Haysboro, Miss.
(mailing address)

WELL LOCATION:
sec 1 T 9 N R 7 E
S W
8 miles N of Haysboro
(distance) (direction) (nearest town)

WELL PURPOSE: home
(home, irrigation, municipal, industrial)

- WELL COMPLETION DATA:
- (1) diameter (inches) 2"
 - (2) total depth (feet) 131'
 - (3) static water level (feet) 102' below above top of ground.
 - (4) casing steel, 126' (material) (depth)
2" if telescope see back. (size)
 - (5) screen 5', 126' (length) (depth to top)
1 1/4 Johnson S.S. 10 slot (size) (material)
 - (6) pump 1 1/2 6 (HP) (yield gpm)
elec (type power)
 - (7) electric log no (yes or no)
(organization running log)
 - (8) how well bottom plugged
flush point

description of formations encountered	from	to
<u>red clay</u>	<u>0</u>	<u>20</u>
<u>red sand</u>	<u>20</u>	<u>57</u>
<u>thin rock</u>		<u>57</u>
<u>red chalk</u>	<u>57</u>	<u>75</u>
<u>sand</u>	<u>75</u>	<u>133</u>
<u>blue chalk</u>	<u>133</u>	<u>155</u>
<u>rock</u>	<u>155</u>	<u>156</u>
<u>blue chalk</u>	<u>156</u>	<u>160</u>

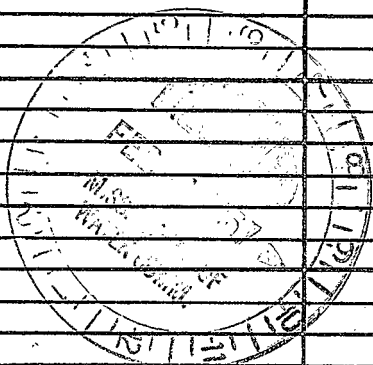

DRILLERS REMARKS:
2" shell funnel above screen

