

Wayne  
H63  
7-67

MISSISSIPPI  
BOARD OF WATER COMMISSIONERS  
416 North State Street  
Jackson, Mississippi 39201

WATER WELL DRILLERS LOG

July 12, 1967 date well completed  
Bortel Drilling & Equip firm name  
Wayne county well located

LANDOWNER: Grady Chapman

description of formations encountered	from	to
	red clay	0
sand	10	17
blue chalk	17	150
thin rock at		40
" " " "		50
" " " "		61
blue rock strata	71	76
blue chalk	76	150
rock strata	150	170
reduced hole at 168'		
fine sand with gravel	170	180
stopped on chalk		

At 4 Waynesboro, Miss (mailing address)

WELL LOCATION:  
sec. 3 T. 9 N R. 7 E  
8 miles north of Waynesboro (distance) (direction) (nearest town)

WELL PURPOSE: home (home, irrigation, municipal, industrial)

WELL COMPLETION DATA:


- (1) diameter (inches) 2'
- (2) total depth (feet) 180'
- (3) static water level (feet) 5 below above top of ground.
- (4) casing steel 168' (material) (depth)  
2' (size) if telescope see back.
- (5) screen 11' 169' (length) (depth to top)  
1/4 80 ga brass joggled (size) (material)
- (6) pump 2 4 (HP) (yield gpm)  
elec. (type power)
- (7) electric log no (yes or no)  
(organization running log)
- (8) how well bottom plugged flush screen

DRILLERS REMARKS:



If well telescopes please sketch and show depths.

GROUND LEVEL

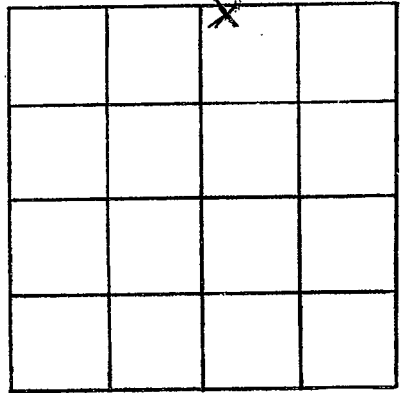

SECTION 3

Please indicate well location X.

ADDITIONAL INFORMATION

If more than one screen,  
show locations of each on sketch.