

Wayne
H 64
9-67

MISSISSIPPI
BOARD OF WATER COMMISSIONERS
416 North State Street
Jackson, Mississippi 39201

WATER WELL DRILLERS LOG

9-16 1967 Roy V. West *Wayne*
date well completed firm name county well located

LANDOWNER: *Robert Butler*
Rt 1
Waynesboro
(mailing address)


description of fomations encountered	from	to
<i>red clay</i>	<i>0</i>	<i>30</i>
<i>sandy clay</i>	<i>30</i>	<i>60</i>
<i>sand</i>	<i>60</i>	<i>80</i>
<i>sand rock</i>	<i>80</i>	<i>85</i>
<i>sandy clay</i>	<i>85</i>	<i>90</i>
<i>sand</i>	<i>90</i>	<i>130</i>

WELL LOCATION:
sec. *20* T. *9* N. R. *7* E
S. W.
5 miles *n.w* of *Waynesboro*
(distance) (direction) (nearest town)

WELL PURPOSE: *home*
(home, irrigation, municipal, industrial)

WELL COMPLETION DATA:

- (1) diameter (inches) *2*
- (2) total depth (feet) *130*
- (3) static water level (feet) *80* below above top of ground.
- (4) casing *galv*, *124*
(material) (depth)
2 if telescope see back.
(size)
- (5) screen *6*, *124*
(length) (depth to top)
1 1/2, *Brass*
(size) (material)
- (6) pump *1/2 red*, *4*
(HP) (yield gpm)
REA
(type power)
- (7) electric log *no*
(yes or no)
(organization running log)
- (8) how well bottom plugged *wash hole*

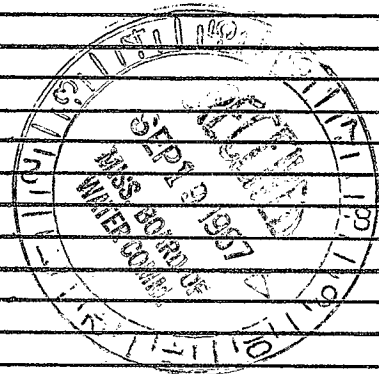

DRILLERS REMARKS:

If well telescopes please sketch and show depths.

GROUND LEVEL

	X		

SECTION ~~19~~ 20

Please indicate well location X.

ADDITIONAL INFORMATION

If more than one screen, show locations of each on sketch.