

Wayne  
H66  
9-67

MISSISSIPPI  
BOARD OF WATER COMMISSIONERS  
416 North State Street  
Jackson, Mississippi 39201

WATER WELL DRILLERS LOG

Sept 30 19 67 Porter Drilling & Log Wayne  
date well completed firm name county well located

LANDOWNER: Howard Arnold

description of formations encountered

211 Waynesboro  
(mailing address)

description of formations encountered	from	to
over clay	0	15
sand	15	75
chalk	75	78
sand	78	100
chalk	100	102
sand	102	111
stagnant white stilt in sand		


WELL LOCATION:  
sec. 19 T. 9 N. R. 7 E. S. 5 W. 6  
(distance) miles (direction) NW of (nearest town) Waynesboro

WELL PURPOSE: none  
(home, irrigation, municipal, industrial)

WELL COMPLETION DATA:


- (1) diameter (inches) 2"
- (2) total depth (feet) 111
- (3) static water level (feet) 8.4 below top of ground.
- (4) casing 2" (material), 105' (depth)  
2" (size) If telescope see back.
- (5) screen 5 (length), 105 (depth to top)  
1/4 (size), 7 salt S.S. (material)
- (6) pump 1/2 (HP), 3 1/2 (yield gpm)  
elec (type power)
- (7) electric log no (yes or no)  
(organization running log)
- (8) how well bottom plugged

DRILLERS REMARKS:

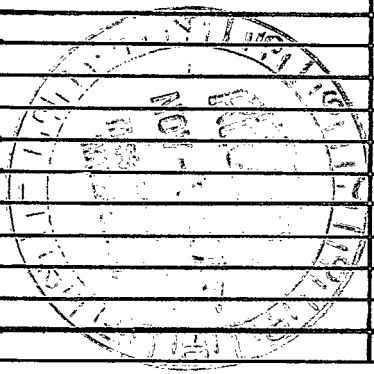

If well telescopes please sketch and show depths.

GROUND LEVEL

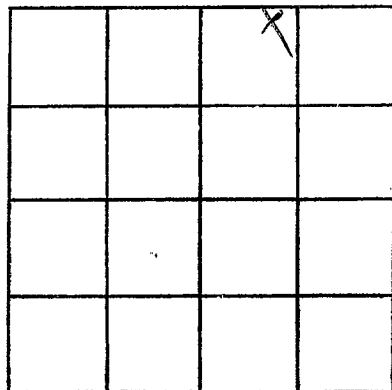

SECTION 19

Please indicate well location X.

ADDITIONAL INFORMATION

If more than one screen, show locations of each on sketch.