


**MISSISSIPPI
BOARD OF WATER COMMISSIONERS
416 North State Street
Jackson, Mississippi 39201**

WATER WELL DRILLERS LOG

Wayne
H 67
9-67


Sept 26 1967 Porter Drilling & Log Wayne
date well completed firm name county well located

LANDOWNER: <u>Mrs. Kate Cason</u>	description of formations encountered	from	to
<u>At 421 Magnolia Ave Miss</u> (mailing address)	<u>red clay</u> <u>fine blue sand</u> <u>cutput on chucks</u>	<u>0</u>	<u>15</u> <u>15</u> <u>28</u>
WELL LOCATION: sec. <u>14</u> T. <u>9</u> N. R. <u>7</u> E. S. W. <u>6</u> miles <u>N</u> of <u>Waynesboro</u> (distance) (direction) (nearest town)	<u>screen sand packed</u>		
WELL PURPOSE: <u>home</u> (home, irrigation, municipal, industrial)			
WELL COMPLETION DATA: (1) diameter (inches) <u>2"</u> (2) total depth (feet) <u>28'</u> (3) static water level (feet) <u>13'</u> below above top of ground. (4) casing <u>2'</u> <u>18'</u> (material) (depth) <u>2'</u> if telescope see back. (size) (5) screen <u>10'</u> <u>18'</u> (length) (depth to top) <u>1/4"</u> <u>60 brass jacket</u> (size) (material) (6) pump <u>1/2</u> <u>5</u> (HP) (yield gpm) <u>elec</u> (type power) (7) electric log <u>no</u> (yes or no) <u></u> (organization running log) (8) how well bottom plugged <u></u>			
DRILLERS REMARKS: <u></u>			

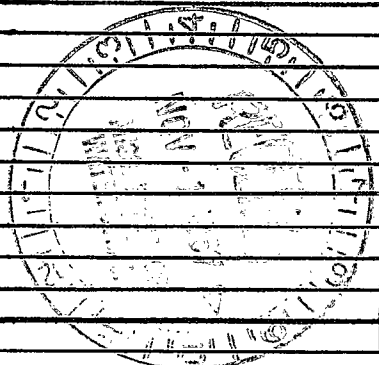

If well telescopes please sketch and show depths.

GROUND LEVEL

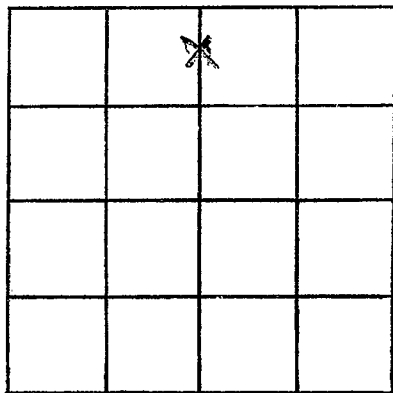

SECTION 14

Please indicate well location X.

ADDITIONAL INFORMATION

If more than one screen, show locations of each on sketch.