

**MISSISSIPPI
BOARD OF WATER COMMISSIONERS
416 North State Street
Jackson, Mississippi 39201**

WATER WELL DRILLERS LOG

Oct 6 1967 Boyer Drilling Co Wayne
 date well completed firm name county well located

LANDOWNER: Robert L. Graham

description of formations encountered

from to

At 1 Shubuta
 (mailing address)

<u>red clay</u>	<u>0</u>	<u>12</u>
<u>red sand</u>	<u>12</u>	<u>18</u>
<u>red to coarse sand</u>	<u>18</u>	<u>30</u>
<u>blue chert</u>	<u>30</u>	<u>31</u>

WELL LOCATION:

sec. 4 T. 9 N. R. 7 E.
 S. W.
8 miles NW of Waynesboro
 (distance) (direction) (nearest town)

WELL PURPOSE: drill
 (home, irrigation, municipal, industrial)


WELL COMPLETION DATA:

- (1) diameter (inches) 1 1/4
- (2) total depth (feet) 29
- (3) static water level (feet) 15 below above top of ground.
- (4) casing steel, 24,
 (material) (depth)
1 1/4 if telescope see back.
 (size)
- (5) screen 5, 24
 (length) (depth to top),
1 1/4, 5' 60 ga brass jacket
 (size) (material)
- (6) pump pitcher pump 8
 (HP) (yield gpm)

 (type power)
- (7) electric log _____
 (yes or no)


 (organization running log)
- (8) how well bottom plugged _____

DRILLERS REMARKS: _____

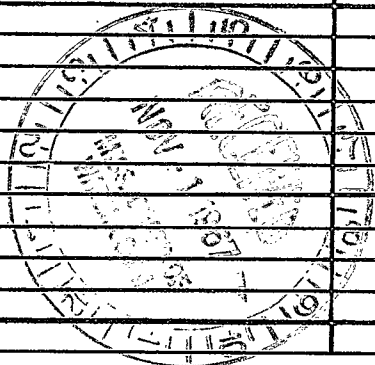

If well telescopes please sketch and show depths.

GROUND LEVEL

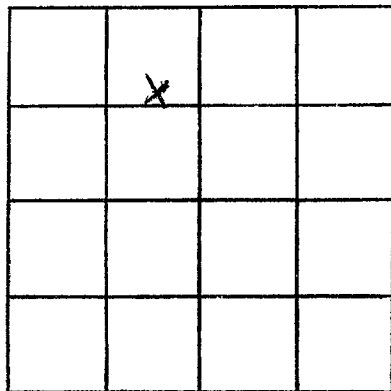

SECTION 4

Please indicate well location X.

ADDITIONAL INFORMATION

If more than one screen,
show locations of each on sketch.