

Wayne
H69
10-67

MISSISSIPPI
BOARD OF WATER COMMISSIONERS
416 North State Street
Jackson, Mississippi 39201

WATER WELL DRILLERS LOG

Oct 18 19 Porter Drilling Co Wayne
date well completed firm name county well located


LANDOWNER: Mrs Ethel
Coppeling
Rt 1 Waynesboro Miss
(mailing address)

WELL LOCATION:
sec. 19 T. 9 N. R. 7 E. W1
6 miles NW of Waynesboro
(distance) (direction) (nearest town)

WELL PURPOSE: home
(home, irrigation, municipal, industrial)

WELL COMPLETION DATA:
(1) diameter (inches) 2"
(2) total depth (feet) 102
(3) static water level (feet) 84 below above top of ground.
(4) casing steel, 98'
(material) (depth)
2" if telescope see back.
(size)
(5) screen 1", 98'
(length) (depth to top)
1/4", 7 slot S.S.
(size) (material)
(6) pump 3/4 5
(HP) (yield gpm)
elec
(type power)
(7) electric log no
(yes or no)
(organization running log)
(8) how well bottom plugged


description of formations encountered	from	to
<u>red clay</u>	<u>0</u>	<u>10</u>
<u>sand</u>	<u>10</u>	<u>60</u>
<u>sand & pea gravel</u>	<u>60</u>	<u>89</u>
<u>Chalk & sand</u>	<u>89</u>	<u>95</u>
<u>clean med coarse sand</u>	<u>95</u>	<u>102</u>
<u>stagnant white silt in sand</u>		

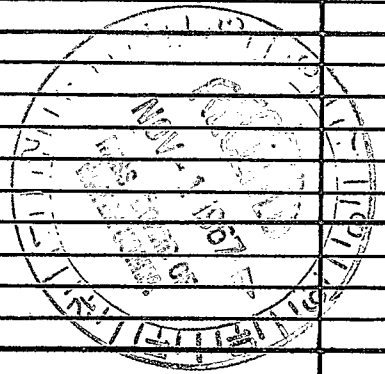

DRILLERS REMARKS:

If well telescopes please sketch and show depths.

GROUND LEVEL

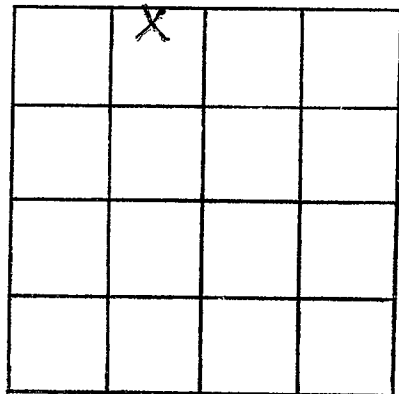

SECTION 19

Please indicate well location X.

ADDITIONAL INFORMATION

If more than one screen, show locations of each on sketch.