

**MISSISSIPPI
BOARD OF WATER COMMISSIONERS
416 North State Street
Jackson, Mississippi 39201**

WATER WELL DRILLERS LOG

Wayne
H70
10-67

Oct 17 1967 Porter Drilling & Inc Wayne
date well completed firm name county well located

LANDOWNER: Mrs Louis Webb

description of formations encountered	from	to

At 4 Waynesboro Miss
(mailing address)

<u>red clay</u>	<u>0</u>	<u>15</u>
<u>red sand</u>	<u>15</u>	<u>38</u>
<u>thin rock</u>		<u>38</u>
<u>red chalk</u>	<u>38</u>	<u>48</u>
<u>rock</u>	<u>48</u>	<u>50</u>
<u>white chalk</u>	<u>50</u>	<u>112</u>
<u>sand & chalk</u>	<u>112</u>	<u>118</u>
<u>fine sand</u>	<u>118</u>	<u>139</u>

WELL LOCATION:
sec. 6 T. 9 N. R. 7 E. W
7 miles N of Waynesboro
(distance) (direction) (nearest town)


WELL PURPOSE: home
(home, irrigation, municipal, industrial)

stopped white still in sand

WELL COMPLETION DATA:


- (1) diameter (inches) 2"
- (2) total depth (feet) 139
- (3) static water level (feet) 111 below above top of ground.
- (4) casing steel, 133, (material) (depth)
2" (size) If telescope see back.
- (5) screen 5, 134 (length) (depth to top)
1/4, Galv. S. S (size) (material)
- (6) pump 1 sub pump 3 1/2 (HP) (yield gpm)
elec (type power)
- (7) electric log no (yes or no)
(organization running log)
- (8) how well bottom plugged _____

DRILLERS REMARKS: _____

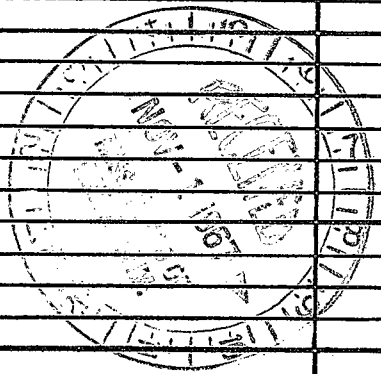

If well telescopes please sketch and show depths.

GROUND LEVEL

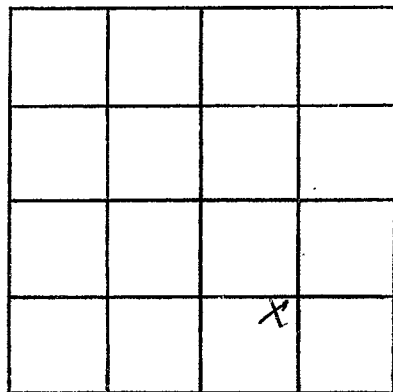

SECTION 

Please indicate well location X.

ADDITIONAL INFORMATION

If more than one screen,
show locations of each on sketch.