

Wayne
H71
1-68

MISSISSIPPI
BOARD OF WATER COMMISSIONERS
416 North State Street
Jackson, Mississippi 39201

WATER WELL DRILLERS LOG

Jan 20, 1968 date well completed
Parker Drilling & Log firm name
Wayne county well located

LANDOWNER: Kennell Stanley

description of formations encountered	from	to
---------------------------------------	------	----

At 4 Haynesboro Miss (mailing address)

red clay	0	10
sand	10	13
chalk	13	18
sand & chalk	18	22
chalk	22	26
rock	26	29
blue chalk	29	128
thin rock		128
thin rock		140
thin rock		150
thin rock		155
blue chalk	128	155
blue chalk	155	225
rock strata	225	242 1/2
sand & chalk	242 1/2	247 1/2
clean sand	247 1/2	250
chalk & sand	250	253
stopped on chalk		


WELL LOCATION:
sec 11 T 9 N R 7 E S W
6 miles N of Haynesboro (distance) (direction) (nearest town)

WELL PURPOSE: home (home, irrigation, municipal, industrial)

WELL COMPLETION DATA:


- (1) diameter (inches) 2"
- (2) total depth (feet) 253'
- (3) static water level (feet) 35 below top of ground.
- (4) casing steel, 242 (material) (depth)
- 2" if telescope see back. (size)
- (5) screen 12' (length) 241 (depth to top)
- 1 1/4" brass jacket (size) (material) 80 ga
- (6) pump 1 (HP) 7 (yield gpm)
- elec (type power)
- (7) electric log no (yes or no)
- (organization running log)
- (8) how well bottom plugged flush gravel

DRILLERS REMARKS:

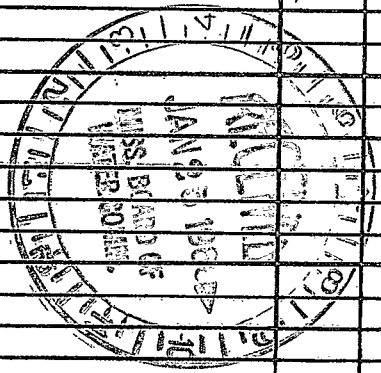

If well telescopes please sketch and show depths.

GROUND LEVEL

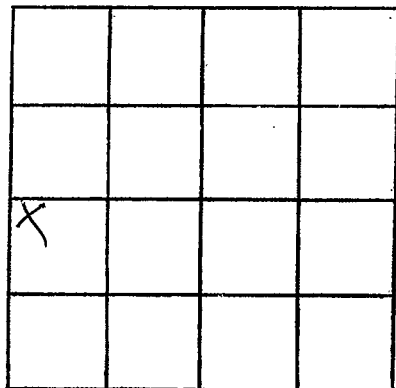

SECTION 11

Please indicate well location X.

ADDITIONAL INFORMATION

If more than one screen,
show locations of each on sketch.