

WAYNE

MISSISSIPPI BOARD OF WATER COMMISSIONERS

H073

CODED

5-17-62

WATER WELL DRILLERS LOG

Date: 5/17, 1962, Driller: G.P. Clark County Jones

384/7

(Name)

(1) Owner of Land: Archie Baggett
(Name)
Rt 1 Waynesboro Miss
(Address)

Description & Color of Materials
Sand, Clay, Red Clay, Shell, etc.

Thick-
ness
Feet

Depth
Feet

0/10 Sandy Clay
10-111 Sand & Gravel

100
101

(2) Location: 1/4, 1/4, Sec. 20 T. 9 R. 7

4 miles N.E. of Waynesboro
(distance) (direction) (Nearest Town)

(3) Topography: (Hilly) (Flat) (Level)

(4) Purpose of Well: Domestic Irrigation
 Municipal, Industrial, Other

CODED

Information upon completion of well:


- (1) Diameter 2 inches.
- (2) Total Depth 111 feet.
- (3) Water Level 90 feet below top of ground.
- (4) Cased to 105, Size 2
- (5) Screen: Size 1 1/4, Length 6
- (6) Were any formations sealed against pollution?

yes, no.

If YES depth of formation

Why

Drillers Remarks:

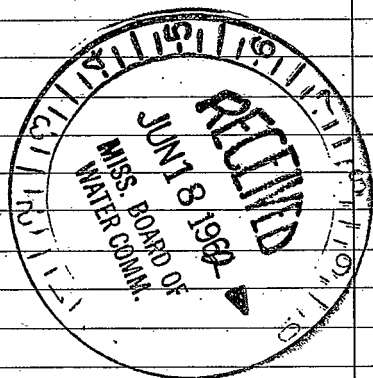

(Use Back Side)

Well No.

