

WAYNE

MISSISSIPPI BOARD OF WATER COMMISSIONERS

H74

CODED

1-2-63

WATER WELL DRILLERS LOG

Date: 1/2, 1963, Driller: C. P. Clark County, Wayne

5P 34 383 403 460 510 (Name)


(1) Owner of Land:	Description & Color of Materials Sand, Clay, Red Clay, Shell, etc.	Thick- ness Feet	Depth Feet
Humble oil (Name)	0-82 Yellow Sand	82	
Hattiesburg Miss (Address)	82-82 1/3 Rock	1/3	
(2) Location: 1/4, 1/4, Sec. 20 1 9 9	82 1/3 - 115 Clay	3 1/2	
7 miles MW of Waynesboro (distance) (direction) (Nearest Town)	115-140 Rock	25	
(3) Topography: <input checked="" type="checkbox"/> (Hilly) <input type="checkbox"/> (Flat) <input type="checkbox"/> (Level)	140-380 Blue Clay	240	
(4) Purpose of Well: (Domestic, Irrigation, Municipal, Industrial, Other)	380-410 Clay + rocks	70	
	410-460 Clay	50	
	460-480 Sand	20	
	480-520 Clay	40	
	520-530 Sandy Clay	10	
	530-544 Sand	14	

Information upon completion of well:

- (1) Diameter 4 inches.
- (2) Total Depth 544 feet.
- (3) Water Level 96 feet below top of ground.
- (4) Cased to 524, Size 4x2 1/2
- (5) Screen: Size 2 1/2, Length 20
- (6) Were any formations sealed against pollution?
 yes, no.

If YES depth of formation 99 ft
Why Lost Circulation

Drillers Remarks:

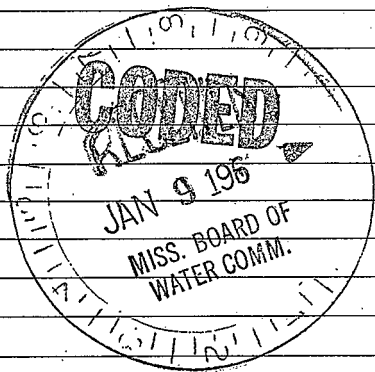

(Use Back Side)

Well No.

