

WAYNE MISSISSIPPI BOARD OF WATER COMMISSIONERS

H76

2-22-63

WATER WELL DRILLERS LOG

**CODED**

Date: 2/22, 1963, Driller: (P. Clark) County Wayne

389/7

(Name)

(1) Owner of Land Archie Baggett  
 Pt #1 Waynesboro  
 (Name)  
 (Address)

Description & Color of Materials  
 Sand, Clay, Red Clay, Shell, etc.

Thick-  
ness  
Feet

Depth  
Feet

0-110 Sand

110

(2) Location: 1/4, 1/4, Sec. 20 T. 9 R. 7,  
5 miles N.W of Waynesboro  
 (distance) (direction) (Nearest Town)

(3) Topography: \_\_\_\_\_  
 (Hilly) (Flat) (Level)

(4) Purpose of Well: \_\_\_\_\_  
 (Domestic Irrigation  
 Municipal, Industrial, Other)

Information upon completion of well:


- (1) Diameter 2 inches.
- (2) Total Depth 110 feet.
- (3) Water Level 98 feet below top of ground.
- (4) Cased to 105, Size 2 in
- (5) Screen: Size 1/4, Length 5 ft
- (6) Were any formations sealed against pollution?  
 \_\_\_\_\_ yes,  no.

If YES depth of formation \_\_\_\_\_

Why \_\_\_\_\_

Drillers Remarks: \_\_\_\_\_

**CODED**

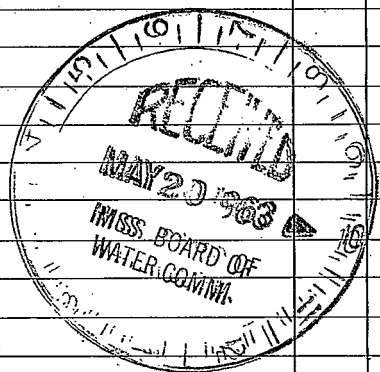

(Use Back Side)

Well No.

[The page contains extremely faint and illegible text, likely bleed-through from the reverse side of the document. No specific content can be transcribed.]