

WAYNE

MISSISSIPPI BOARD OF WATER COMMISSIONERS

H78

5-15-62

WATER WELL DRILLERS LOG

CODED

Date: 5/15, 1962, Driller: O.P. Clark County: Wayne

384/21

(Name)

(1) Owner of Land:	Description & Color of Materials Sand, Clay, Red Clay, Shell, etc.	Thick- ness Feet	Depth Feet
Elige Mojingo <small>(Name)</small> Rt #1 Waynesboro Miss <small>(Address)</small>	0-8 Sandy Clay 8-105 Sand & Gravel	8 97	
(2) Location: _____ 1/4, _____ 1/4, Sec. 20 T 9 R 7, 4 miles NE of Waynesboro <small>(distance) (direction) (Nearest Town)</small>			
(3) Topography: <input checked="" type="checkbox"/> (Hilly) <input type="checkbox"/> (Flat) <input type="checkbox"/> (Level)			
(4) Purpose of Well: _____ <small>(Domestic, Irrigation, Municipal, Industrial, Other)</small>			

Information upon completion of well:


CODED

- (1) Diameter 2 inches.
- (2) Total Depth 105 feet.
- (3) Water Level 88 feet below top of ground.
- (4) Cased to 100, Size 2.
- (5) Screen: Size 1/4, Length 5.
- (6) Were any formations sealed against pollution?
 yes, no.

If YES depth of formation _____

Why _____

Drillers Remarks: _____

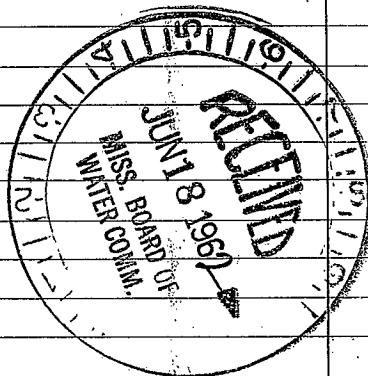

(Use Back Side)

Well No.

